

CARD MUST BE TYPED

State of Kansas

CARD MUST BE SIGNED

## NOTICE OF INTENTION TO DRILL

(see rules on reverse side)

Starting Date .. on or before March 1 St 1987  
month day year

API Number 15— 207-25,501-00-00

OPERATOR: License # 3275

Name Mark O Thompson

Address 920 E 13 Winfield, Ks.

City/State/Zip 67156

Contact Person

Phone 316-221-4159

CONTRACTOR: License # 5495

Name McPherson Drilg. Co.

City/State Rt 2 Box 168, Augusta, Ks.

Well Drilled For: Well Class: Type Equipment:

☒ Oil ☐ SWD ☐ Infield ☒ Mud Rotary☐ Gas ☐ Inj ☒ Pool Ext. ☐ Air Rotary☐ OWWO ☐ Expl ☒ Wildcat ☐ Cable

If OWWO: old well info as follows:

Operator

Well Name

Comp Date Old Total Depth

I certify that well will comply with K.S.A. 55-101, et seq., plus eventually plugging hole to KCC specifications.

Date 2/19/87 Signature of Operator or Agent Mark O Thompson Title Owner

For KCC Use:

Conductor Pipe Required feet; Minimum Surface Pipe Required 40 feet per Alt.

This Authorization Expires 2-19-87 Approved By 2-19-87

SE SE Sec. 19 Twp 24 S, Rg. 15 E ☒ East ☐ West

660 ft. Ft. from South Line of Section

660 ft. Ft. from East Line of Section

(Note: Locate well on Section Plat on reverse side)

Nearest lease or unit boundary line 660 feet

County Woodson

Lease Name Walton Well # 1

Ground surface elevation feet MSL

Domestic well within 330 feet: ☐ yes ☒ noMunicipal well within one mile: ☐ yes ☒ no

Depth to bottom of fresh water 40 ft.

Depth to bottom of usable water 150 ft.

Surface pipe by Alternate: 1 2

Surface pipe planned to be set 40 ft.

Conductor pipe required

Projected Total Depth 1500 ft. feet

Formation Miss.


feet

Must be filed with the K.C.C. five (5) days prior to commencing well  
This card void if drilling not started within six (6) months of date received by K.C.C.

**Important procedures to follow:**

1. Notify District office before setting surface casing.
2. Set surface casing by circulating cement to the top.
3. File completion forms ACO-1 with K.C.C. within 90 days of well completion, following instructions on ACO-1, side 1, and including copies of wireline logs.
4. Notify District office 48 hours prior to old well workover or re-entry.
5. Prior to filing Intent, prepare a proposed plugging plan in case well is D & A, then obtain approval of plan when calling district office prior to setting surface pipe.
6. Submit plugging report (CP-4) to K.C.C. after plugging is completed.
7. Obtain an approved injection docket number before disposing of salt water.
8. Notify K.C.C. within 10 days when injection commences or terminates.
9. If an alternate 2 completion, cement in the production pipe from below any usable water to surface within 120 days of spud date.

**A Regular Section of Land  
1 Mile = 5,280 Ft.**

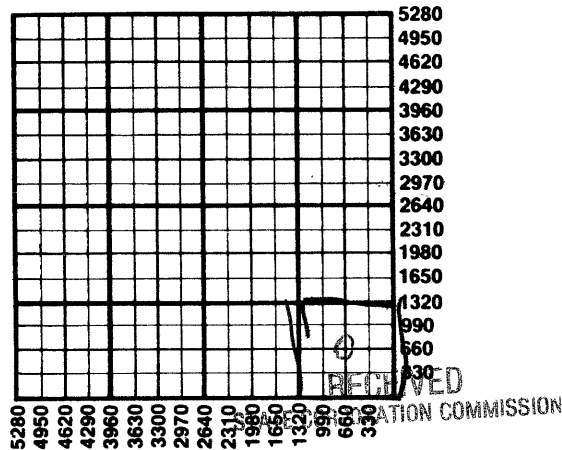

FEB 19 1987

CONSERVATION DIVISION  
Wichita, Kansas

2-19-87

State Corporation Commission of Kansas  
Conservation Division  
200 Colorado Derby Building  
Wichita, Kansas 67202  
(316) 263-3238