

CARD MUST BE TYPED

State of Kansas

CARD MUST BE SIGNED

NOTICE OF INTENTION TO DRILL

(see rules on reverse side)

Expected Spud Date..... SEPTEMBER 17, 1987
month day year

API Number 15— 003-22,839-00-00 ✓

OPERATOR: License # 3310
Name..... VINCE KENT
Address..... 215 WEST 6TH
City/State/Zip..... GARNETT, KS 66032
Contact Person..... VINCE KENT
Phone..... 913-448-3922

S 1/2 NE SE Sec. 14 Twp. 21 S, Rg. 20 X East
2310 Ft. from South Line of Section
660 Ft. from East Line of Section

(Note: Locate well on Section Plat on reverse side)

CONTRACTOR: License # 5820
Name..... KENT DRILLING
City/State..... GARNETT, KS 66032

Nearest lease or unit boundary line..... 330 feet
County..... ANDERSON
Lease Name..... IOWA COLLEGE Well #..... 3

Well Drilled For: Well Class: Type Equipment:
XXXX OK Storage X Infield X Mud Rotary
— Gas — Inj — Pool Ext. — Air Rotary
— OWWO — Expl — Wildcat — Cable

Ground surface elevation..... feet MSL
Domestic well within 330 feet: —yes Xno
Municipal well within one mile: —yes Xno
Depth to bottom of fresh water..... 120
Depth to bottom of usable water..... 120 / 125

If OWWO: old well info as follows:
Operator.....
Well Name.....
Comp Date..... Old Total Depth.....

Surface pipe by Alternate: 1 2 X
Surface pipe planned to be set..... 20
Conductor pipe required.....
Projected Total Depth..... 700 feet
Formation..... SQUIRREL

I certify that well will comply with K.S.A. 55-101, et seq., plus eventually plugging hole to KCC specifications.
Date..... 9-14-87..... Signature of Operator or Agent Tom R. Engeman Title..... AS AGENT


For KCC Use:
Conductor Pipe Required..... feet: Minimum Surface Pipe Required..... 20 feet per Alt. X (2)
This Authorization Expires 3-14-88 Effective 9-19-87 Approved By 9-14-87

Must be filed with the K.C.C. five (5) days prior to commencing well
This card void if drilling not started within six (6) months of date received by K.C.C.

Important procedures to follow:

1. Notify District office before setting surface casing.
2. Set surface casing by circulating cement to the top.
3. File completion forms ACO-1 with K.C.C. within 120 days of well spud date, following instructions on ACO-1, side 1, and including copies of wireline logs.
4. Notify District office 48 hours prior to old well workover or re-entry.
5. Prior to filing Intent, prepare a proposed plugging plan in case well is D & A, then obtain approval of plan when calling district office prior to setting surface pipe.
6. Submit plugging report (CP-4) to K.C.C. after plugging is completed.
7. Obtain an approved injection docket number before disposing of salt water.
8. Notify K.C.C. within 10 days when injection commences or terminates.
9. If an alternate 2 completion, cement in the production pipe from below any usable water to surface within 120 days of spud date.

A Regular Section of Land
1 Mile = 5,280 Ft.

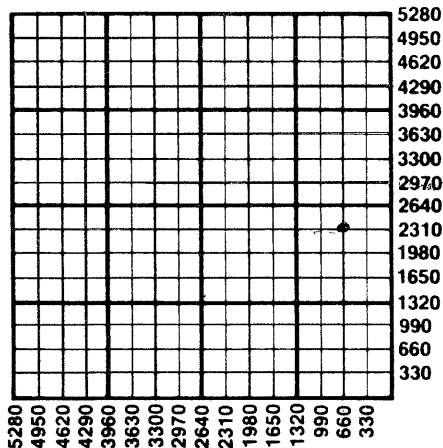

RECEIVED
STATE CORPORATION COMMISSION

SEP 14 1987
09-14-87
CONSERVATION DIVISION
Wichita, Kansas

State Corporation Commission of Kansas
Conservation Division
200 Colorado Derby Building
Wichita, Kansas 67202-1212
(316) 263-3238