

CARD MUST BE TYPED

State of Kansas

CARD MUST BE SIGNED

NOTICE OF INTENTION TO DRILL

(see rules on reverse side)

Starting Date January 12, 1987
month day year

API Number 15- 003-22,773-00-00 ✓
X East

OPERATOR: License # 6004
Name Caldwell Enterprises, Inc.
Address Box 42
City/State/Zip ... Garnett, KS... 66032
Contact Person Glen Caldwell
Phone 913.448.3578

App. SW .SW. NW... Sec...15. Twp.21... S, Rg....20.. — West
..... 2810 Ft. from South Line of Section
..... 5115 Ft. from East Line of Section

(Note: Locate well on Section Plat on reverse side)

CONTRACTOR: License # 5820
Name Kent Drilling Co.
City/State Garnett, KS... 66032

Nearest lease or unit boundary line 165 feet
County Anderson

Lease Name... Weiss Well #... 2A

Ground surface elevation ... na feet MSL

Domestic well within 330 feet: _____ yes no

Municipal well within one mile: _____ yes no

Depth to bottom of fresh water 20

Depth to bottom of usable water 125

Surface pipe by Alternate: _____ 1 _____ 2

Surface pipe planned to be set 20

Conductor pipe required

Projected Total Depth 850 feet

Formation Squirrel

Well Drilled For: Well Class: Type Equipment:
X ___ Oil ___ SWD X ___ Infield X ___ Mud Rotary
___ Gas ___ Inj ___ Pool Ext. ___ Air Rotary
___ OWWO ___ Expl ___ Wildcat ___ Cable

If OWWO: old well info as follows:

Operator
Well Name
Comp Date Old Total Depth

I certify that well will comply with K.S.A. 55-101, et seq., plus eventually plugging hole to KCC specifications.

Date ... 1/7/87 Signature of Operator or Agent *Clain Barber* Title as agent

For KCC Use:

Conductor Pipe Required feet; Minimum Surface Pipe Required 20 feet per Alt. *4 2*


This Authorization Expires 7-7-87 Approved By 1-7-87 *RE*

Must be filed with the K.C.C. five (5) days prior to commencing well
This card void if drilling not started within six (6) months of date received by K.C.C.

Important procedures to follow:

1. Notify District office before setting surface casing.
2. Set surface casing by circulating cement to the top.
3. File completion forms ACO-1 with K.C.C. within 90 days of well completion, following instructions on ACO-1, side 1, and including copies of wireline logs.
4. Notify District office 48 hours prior to old well workover or re-entry.
5. Prior to filing Intent, prepare a proposed plugging plan in case well is D & A, then obtain approval of plan when calling district office prior to setting surface pipe.
6. Submit plugging report (CP-4) to K.C.C. after plugging is completed.
7. Obtain an approved injection docket number before disposing of salt water.
8. Notify K.C.C. within 10 days when injection commences or terminates.
9. If an alternate 2 completion, cement in the production pipe from below any usable water to surface within 120 days of spud date.

**A Regular Section of Land
1 Mile = 5,280 Ft.**

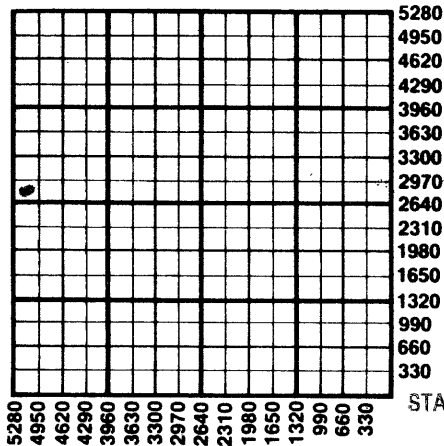

RECEIVED
STATE CORPORATION COMMISSION

JAN 7 1987
01-07-87
CONSERVATION DIVISION
Wichita, Kansas

State Corporation Commission of Kansas
Conservation Division
200 Colorado Derby Building
Wichita, Kansas 67202
(316) 263-3238