

CARD MUST BE TYPED

State of Kansas

CARD MUST BE SIGNED ✓

NOTICE OF INTENTION TO DRILL

(see rules on reverse side)

Expected Spud Date..... JULY 16, 1987

month day year

#6004

API Number 15—

003-22,824-00-00

East

OPERATOR: License #

CALDWELL ENTERPRISES, INC.

App. C E/2 NW

Sec. 15 Twp. 21 S, Rg. 20

Name.....

P.O. BOX 42

3960

Ft. from South Line of Section

Address.....

GARNETT, KANSAS 66032

3580

Ft. from East Line of Section

City/State/Zip.....

GLEN CALDWELL

(Note: Locate well on Section Plat on reverse side)

Contact Person.....

(913) 448-3578

Nearest lease or unit boundary line 700 feet

Phone.....

5820

County..... ANDERSON

CONTRACTOR: License #

KENT DRILLING COMPANY

Lease Name..... WEISS Well # J-18

Name.....

332 W. 8TH, GARNETT, KS 66032

Ground surface elevation feet MSL

City/State.....

Domestic well within 330 feet: _____yes no

Well Drilled For: Well Class: Type Equipment:

- Oil _____ Storage Infield Mud Rotary
- _____ Gas _____ Inj _____ Pool Ext. _____ Air Rotary
- _____ OWWO _____ Expl _____ Wildcat _____ Cable

Municipal well within one mile: _____yes no

If OWWO: old well info as follows:

Operator.....

Well Name.....

Comp Date..... Old Total Depth.....

Depth to bottom of fresh water.....

Depth to bottom of usable water 125

Surface pipe by Alternate: 1 _____ 2

Surface pipe planned to be set 20

Conductor pipe required.....

Projected Total Depth 870 feet

Formation..... SQUIRREL

I certify that well will comply with K.S.A. 55-101, et seq., plus eventually plugging hole to KGC specifications.

Date 7-14-87 Signature of Operator or Agent

LuAnne Collins

AS AGENT

For KCC Use:

Conductor Pipe Required feet; Minimum Surface Pipe Required 20 feet per Alt. (2)


This Authorization Expires 1-14-88 Approved By JAH 7-14-87

Must be filed with the K.C.C. five (5) days prior to commencing well
This card void if drilling not started within six (6) months of date received by K.C.C.

Important procedures to follow:

1. Notify District office before setting surface casing.
2. Set surface casing by circulating cement to the top.
3. File completion forms ACO-1 with K.C.C. within 120 days of well spud date, following instructions on ACO-1, side 1, and including copies of wireline logs.
4. Notify District office 48 hours prior to old well workover or re-entry.
5. Prior to filing Intent, prepare a proposed plugging plan in case well is D & A, then obtain approval of plan when calling district office prior to setting surface pipe.
6. Submit plugging report (CP-4) to K.C.C. after plugging is completed.
7. Obtain an approved injection docket number before disposing of salt water.
8. Notify K.C.C. within 10 days when injection commences or terminates.
9. If an alternate 2 completion, cement in the production pipe from below any usable water to surface within 120 days of spud date.

A Regular Section of Land 1 Mile = 5,280 Ft.

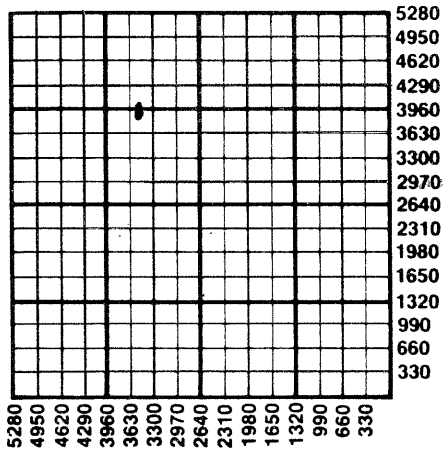

State Corporation Commission of Kansas
Conservation Division

200 Colorado Derby Building
Wichita, Kansas 67202-1212
(316) 263-3238