

CARD MUST BE TYPED

State of Kansas

CARD MUST BE SIGNED

# NOTICE OF INTENTION TO DRILL

(see rules on reverse side)

Expected Spud Date..... 12/11/87  
month day year

API Number 15—003-22,873-00-00

OPERATOR: License #..... 6004  
Name..... CALDWELL ENTERPRISES  
Address..... BOX 42  
City/State/Zip..... GARNETT 66032  
Contact Person..... GLENN CALDWELL  
Phone..... (913) 448-3578

SE SE NE Sec 15 Twp 21 S, Rg 20  
3165  
200  
xx East  
West  
Ft. from South Line of Section  
Ft. from East Line of Section

(Note: Locate well on Section Plat on reverse side)

CONTRACTOR: License #..... 5820  
Name..... Kent Drilling  
City/State..... Garnett, Kansas 66032

Nearest lease or unit boundary line..... 200 feet  
County..... Anderson

Well Drilled For: Well Class: Type Equipment:  
xx Oil Storage xx Infield xx Mud Rotary  
Gas Inj Pool Ext Air Rotary  
OWWO Expl Wildcat Cable

Lease Name..... Ware Well #..... R6  
Ground surface elevation..... feet MSL  
Domestic well within 330 feet: yes xx no  
Municipal well within one mile: yes xx no  
Depth to bottom of fresh water.....  
Depth to bottom of usable water 125  
Surface pipe by Alternate: 1 2 xx  
Surface pipe planned to be set..... 20  
Conductor pipe required.....  
Projected Total Depth..... 870 feet  
Formation..... Squirrel

If OWWO: old well info as follows:

Operator.....  
Well Name.....  
Comp Date..... Old Total Depth.....

I certify that well will comply with K.S.A. 55-101, et seq., plus eventually plugging hole to KCC specifications.

Date..... Signature of Operator or Agent Greg Engler Title As Agent

For KCC Use:

Conductor Pipe Required..... feet; Minimum Surface Pipe Required..... 20 feet per Alt. X(2)  
This Authorization Expires 6-10-88 Approved By PA 12-10-87


EFFECTIVE DATE: 12-15-87

Must be filed with the K.C.C. five (5) days prior to commencing well  
This card void if drilling not started within six (6) months of date received by K.C.C.

### Important procedures to follow:

1. Notify District office before setting surface casing.
2. Set surface casing by circulating cement to the top.
3. File completion forms ACO-1 with K.C.C. within 120 days of well spud date, following instructions on ACO-1, side 1, and including copies of wireline logs.
4. Notify District office 48 hours prior to old well workover or re-entry.
5. Prior to filing Intent, prepare a proposed plugging plan in case well is D & A, then obtain approval of plan when calling district office prior to setting surface pipe.
6. Submit plugging report (CP-4) to K.C.C. after plugging is completed.
7. Obtain an approved injection docket number before disposing of salt water.
8. Notify K.C.C. within 10 days when injection commences or terminates.
9. If an alternate 2 completion, cement in the production pipe from below any usable water to surface within 120 days of spud date.

### A Regular Section of Land 1 Mile = 5,280 Ft.

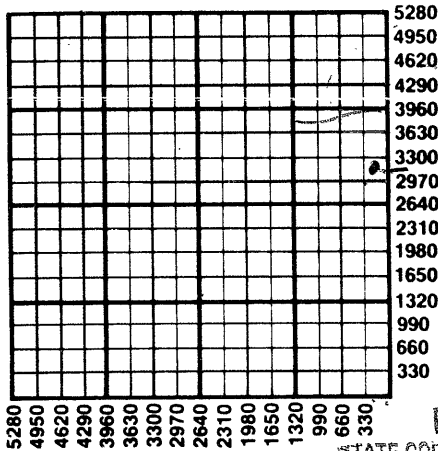

RECEIVED  
STATE CORPORATION

DEC 10 1987  
CONSERVATION DIVISION  
Wichita, Kansas

State Corporation Commission of Kansas  
Conservation Division  
200 Colorado Derby Building  
Wichita, Kansas 67202-1212  
(316) 263-3238