

CARD MUST BE TYPED

State of Kansas
NOTICE OF INTENTION TO DRILL
(see rules on reverse side)

CARD MUST BE SIGNED

Starting Date:3.....20.....85.....
month day year

API Number 15- 207-25,221-00-00

OPERATOR: License #7018.....

..... SW ¹ Sec 1... Twp 24 S, Rge 16... East
(location) West

NameLaymon Oil Company.....

AddressRt. 1.....

.....100..... Ft North from Southeast Corner of Section

City/State/Zip Yates Center, Kansas 66758

.....5180..... Ft West from Southeast Corner of Section

Contact PersonKenneth Laymon.....

(Note: Locate well on Section Plat on reverse side)

Phone316-963-2495.....

Nearest lease or unit boundary line100..... feet.

CONTRACTOR: License #5661.....

CountyWoodson.....

Name ..Kelly Down Drilling Co., Inc.....

Lease NameWilson-Dunne..... Well# 1-SWD

City/State Neosho Falls, Ks. 66758

Domestic well within 330 feet : yes no

Municipal well within one mile : yes no

Well Drilled For: Well Class: Type Equipment:

- Oil Swd Infield Mud Rotary
- Gas Inj Pool Ext. Air Rotary
- OWWO Expl Wildcat Cable

Depth to Bottom of fresh waternone..... feet

Lowest usable water formationnone.....

Depth to Bottom of usable water150..... feet

Surface pipe by Alternate : 1 2

Surface pipe to be set40..... feet

Conductor pipe if any requirednone..... feet

Ground surface elevation1074..... feet MSL

This Authorization Expires7-18-85.....

Approved By3-18-85..... *LC*

If OWWO: old well info as follows:

Operator

Well Name

Comp Date Old Total Depth

Projected Total Depth650..... feet

Projected Formation at TD

Expected Producing Formations

I certify that we will comply with K.S.A. 55-101, et seq., plus eventually plugging hole to K.C.C. specifications.


Date 3/14/85 Signature of Operator or Agent Regina Laymon

Title Agnt
MHC/WOHE 3-18-85

Must be filed with the K.C.C. five (5) days prior to commencing well
 This card void if drilling not started within six (6) months of date received by K.C.C.

Important procedures to follow :

**A Regular Section of Land
 1 Mile = 5,280 Ft.**

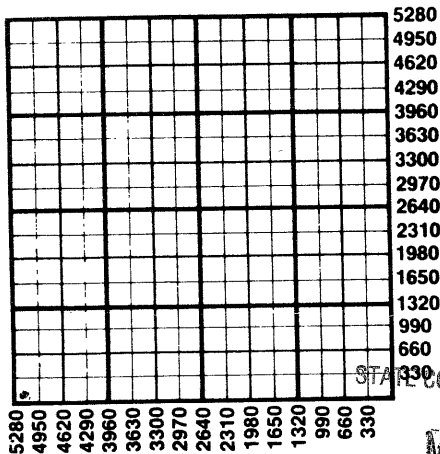

1. Notify District office before setting surface casing.
2. Set surface casing by circulating cement to the top.
3. File completion forms ACO-1 with K.C.C. within 90 days of well completion, following instructions on ACO-1, side 1, and including copies of wireline logs.
4. Notify District office 48 hours prior to old well workover or re-entry.
5. Prior to plugging, prepare a plugging plan, then obtain agreement from the appropriate district office for an approved plugging plan.
6. Submit plugging report (CP-4) to K.C.C. after plugging is completed.
7. Obtain an approved injection docket number before disposing of salt water.
8. Notify K.C.C. within 10 days when injection commences or terminates.
9. If an alternate 2 completion, cement in the production pipe from below any usable water to surface within 120 days of spud date.

STATE CORPORATION COMMISSION

RECEIVED

MAR 18 1985

CONSERVATION DIVISION
 Wichita, Kansas

State Corporation Commission of Kansas
 Conservation Division
 200 Colorado Derby Building
 Wichita, Kansas 67202
 (316) 263-3238

3-18-85