

For KCC Use: 9-11-06
 Effective Date: _____
 District #: 3
 SGA? Yes No

KANSAS CORPORATION COMMISSION
 OIL & GAS CONSERVATION DIVISION

Form C-1

December 2002

Form must be Typed

Form must be Signed

All blanks must be Filled

NOTICE OF INTENT TO DRILL

Must be approved by KCC five (5) days prior to commencing well

Expected Spud Date September 20, 2006
 month day year

Spot SE NW SW Sec. 3 Twp. 32 S. R. 12 East West
1890 feet from N / S Line of Section
4400 feet from E / W Line of Section

OPERATOR: License# 32967 ✓
 Name: Leslie Wolfe
 Address: 208 Stephens Street
 City/State/Zip: Peru, Kansas 67360
 Contact Person: Leslie Wolfe
 Phone: 620-330-3382

Is SECTION Regular Irregular?

(Note: Locate well on the Section Plat on reverse side)

County: Chautauqua
 Lease Name: Mustoe Well #: A 14
 Field Name: Hale-Inge

CONTRACTOR: License# UNKNOWN AT THIS TIME
 Name: ADVISE ON ACO-1 - MUST BE LICENSED BY KCC

Is this a Prorated / Spaced Field? Yes No

Target Formation(s): Little Salt Sand ✓

Nearest Lease or unit boundary: 750

Ground Surface Elevation: 890 feet MSL

Water well within one-quarter mile: Yes No

Public water supply well within one mile: Yes No

Depth to bottom of fresh water: 250 225

Depth to bottom of usable water: 250 225

Surface Pipe by Alternate: 1 2 ✓

Length of Surface Pipe Planned to be set: 40'

Length of Conductor Pipe required: none

Projected Total Depth: 500 ✓

Formation at Total Depth: Little Salt Sand

Water Source for Drilling Operations:

Well Farm Pond Other

DWR Permit #: na

(Note: Apply for Permit with DWR)

Will Cores be taken? Yes No

If Yes, proposed zone: na

RECEIVED

SEP 05 2006

KCC WICHITA

AFFIDAVIT

The undersigned hereby affirms that the drilling, completion and eventual plugging of this well will comply with K.S.A. 55 et. seq.

It is agreed that the following minimum requirements will be met:

1. Notify the appropriate district office **prior** to spudding of well;
2. A copy of the approved notice of intent to drill **shall be** posted on each drilling rig;
3. The minimum amount of surface pipe as specified below **shall be set** by circulating cement to the top; in all cases surface pipe **shall be set** through all unconsolidated materials plus a minimum of 20 feet into the underlying formation.
4. If the well is dry hole, an agreement between the operator and the district office on plug length and placement is necessary **prior to plugging**;
5. The appropriate district office will be notified before well is either plugged or production casing is cemented in;
6. If an ALTERNATE II COMPLETION, production pipe shall be cemented from below any usable water to surface within **120 days** of spud date. Or pursuant to Appendix "B" - Eastern Kansas surface casing order #133,891-C, which applies to the KCC District 3 area, alternate II cementing must be completed within 30 days of the spud date or the well shall be plugged. **In all cases, NOTIFY district office** prior to any cementing.

I hereby certify that the statements made herein are true and to the best of my knowledge and belief.

Date: August 18, 2006 Signature of Operator or Agent: Leslie Wolfe Title: owner

For KCC Use ONLY
 API # 15 - 019-26756-0000
 Conductor pipe required None feet
 Minimum surface pipe required 40 feet per Alt. X2
 Approved by: put 9-6-06
 This authorization expires: 3-6-07
 (This authorization void if drilling not started within 6 months of approval date.)
 Spud date: _____ Agent: _____

Remember to:

- File Drill Pit Application (form CDP-1) with Intent to Drill;
- File Completion Form ACO-1 within 120 days of spud date;
- File acreage attribution plat according to field proration orders;
- Notify appropriate district office 48 hours prior to workover or re-entry;
- Submit plugging report (CP-4) after plugging is completed;
- Obtain written approval before disposing or injecting salt water.
- If this permit has expired (See: authorized expiration date) please check the box below and return to the address below.

Well Not Drilled - Permit Expired

Signature of Operator or Agent: _____

Date: _____

Mail to: KCC - Conservation Division, 130 S. Market - Room 2078, Wichita, Kansas 67202

3
32
12E

IN ALL CASES PLOT THE INTENDED WELL ON THE PLAT BELOW

Plat of acreage attributable to a well in a prorated or spaced field

If the intended well is in a prorated or spaced field, please fully complete this side of the form. If the intended well is in a prorated or spaced field complete the plat below showing that the well will be properly located in relationship to other wells producing from the common source of supply. Please show all the wells and within 1 mile of the boundaries of the proposed acreage attribution unit for gas wells and within 1/2 mile of the boundaries of the proposed acreage attribution unit for oil wells.

API No. 15 - 019-26756-0000
Operator: Leslie Wolfe
Lease: Mustoe
Well Number: 14
Field: Hale-Inge
Number of Acres attributable to well: _____
QTR / QTR / QTR of acreage: SE - NW - SW


Location of Well: County: Chautauqua
1890 feet from N / S Line of Section
4400 feet from E / W Line of Section
Sec. 3 Twp. 32 S. R. 12 East West

Is Section: Regular or Irregular


If Section is Irregular, locate well from nearest corner boundary.
Section corner used: NE NW SE SW

PLAT

*(Show location of the well and shade attributable acreage for prorated or spaced wells.)
(Show footage to the nearest lease or unit boundary line.)*

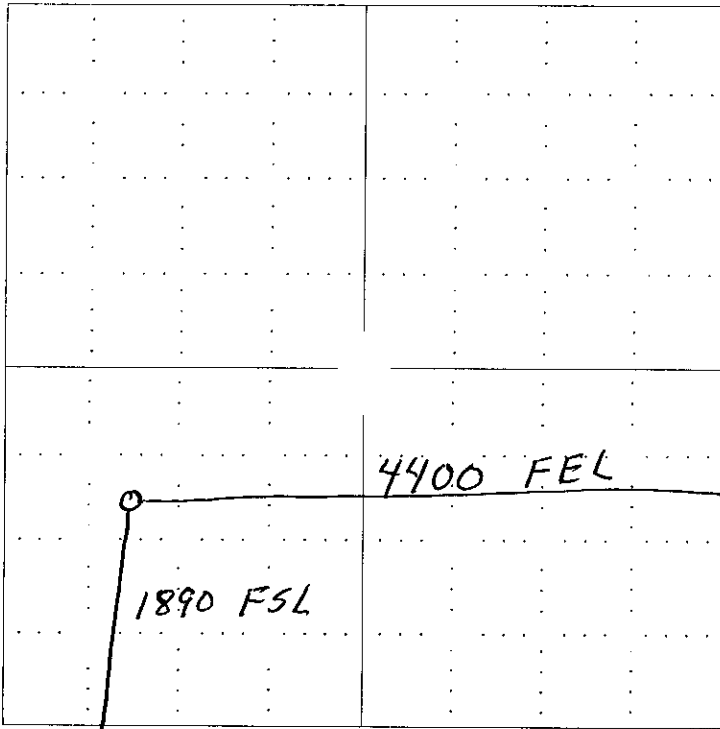

RECEIVED
SEP 05 2006
KCC WICHITA

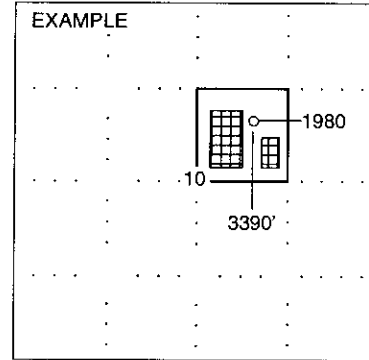

NOTE: In all cases locate the spot of the proposed drilling locaton.


In plotting the proposed location of the well, you must show:

1. The manner in which you are using the depicted plat by identifying section lines, i.e. 1 section, 1 section with 8 surrounding sections, 4 sections, etc.
2. The distance of the proposed drilling location from the section's south / north and east / west.
3. The distance to the nearest lease or unit boundary line.
4. If proposed location is located within a prorated or spaced field a certificate of acreage attribution plat must be attached: (CO-7 for oil wells; CG-8 for gas wells).

**KANSAS CORPORATION COMMISSION
OIL & GAS CONSERVATION DIVISION
APPLICATION FOR SURFACE PIT**

Form CDP-1
April 2004
Form must be Typed

Submit in Duplicate

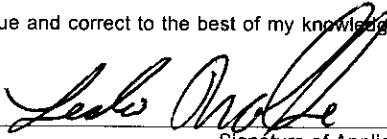Operator Name: Leslie Wolfe		License Number: 32967
Operator Address: 208 Stephens Street Peru, Kansas 67360		
Contact Person: Leslie Wolfe		Phone Number: (620) 330 - 3382
Lease Name & Well No.: Mustoe #14 14		Pit Location (QQQQ): NW SE NW SW
Type of Pit: <input type="checkbox"/> Emergency Pit <input type="checkbox"/> Burn Pit <input type="checkbox"/> Settling Pit <input checked="" type="checkbox"/> Drilling Pit <input type="checkbox"/> Workover Pit <input type="checkbox"/> Haul-Off Pit <small>(If WP Supply API No. or Year Drilled)</small>	Pit is: <input checked="" type="checkbox"/> Proposed <input type="checkbox"/> Existing If Existing, date constructed: na Pit capacity: 350 (bbls)	Sec. 3 Twp. 32 R. 12 <input checked="" type="checkbox"/> East <input type="checkbox"/> West 1890 Feet from <input type="checkbox"/> North / <input checked="" type="checkbox"/> South Line of Section 4400 Feet from <input checked="" type="checkbox"/> East / <input type="checkbox"/> West Line of Section Chautauqua County
Is the pit located in a Sensitive Ground Water Area? <input type="checkbox"/> Yes <input checked="" type="checkbox"/> No		Chloride concentration: na mg/l <small>(For Emergency Pits and Settling Pits only)</small>
Is the bottom below ground level? <input type="checkbox"/> Yes <input checked="" type="checkbox"/> No	Artificial Liner? <input type="checkbox"/> Yes <input checked="" type="checkbox"/> No	How is the pit lined if a plastic liner is not used? clay
Pit dimensions (all but working pits): 60 Length (feet) 7 Width (feet) na N/A: Steel Pits Depth from ground level to deepest point: 6 (feet)		
If the pit is lined give a brief description of the liner material, thickness and installation procedure. dug in natural clay material		Describe procedures for periodic maintenance and determining liner integrity, including any special monitoring. short term pit
Distance to nearest water well within one-mile of pit none feet Depth of water well na feet		Depth to shallowest fresh water 84 feet. KCC WICHITA Source of information: <input type="checkbox"/> measured <input checked="" type="checkbox"/> well owner <input type="checkbox"/> electric log <input type="checkbox"/> KDWR
Emergency, Settling and Burn Pits ONLY: Producing Formation: na Number of producing wells on lease: na Barrels of fluid produced daily: na Does the slope from the tank battery allow all spilled fluids to flow into the pit? <input type="checkbox"/> Yes <input type="checkbox"/> No		Drilling, Workover and Haul-Off Pits ONLY: Type of material utilized in drilling/workover: fresh water Number of working pits to be utilized: 2 Abandonment procedure: evaporate water & backfill Drill pits must be closed within 365 days of spud date.
I hereby certify that the above statements are true and correct to the best of my knowledge and belief.		
August 18, 2006 Date		 Signature of Applicant or Agent

**RECEIVED
SEP 05 2006**

15-019-26756-0000

KCC OFFICE USE ONLY			
Date Received: 9/5/06	Permit Number: _____	Permit Date: 9/5/06	Lease Inspection: <input type="checkbox"/> Yes <input checked="" type="checkbox"/> No

Mail to: KCC - Conservation Division, 130 S. Market - Room 2078, Wichita, Kansas 67202