

CARD MUST BE TYPED

State of Kansas
NOTICE OF INTENTION TO DRILL

(see rules on reverse side)

CARD MUST BE SIGNED

Starting Date 1/1/1986
month day year

API Number 15— 207-25,445-0000

OPERATOR: License # 9513 app.

SE ^{NE} NW. Sec. 8. Twp. 24. S, Rg. 16.
_____ East _____ West

Name Strata Oil, Inc.

1600 Ft. from South Line of Section

Address P.O. Box 3637
City/State/Zip Edmond, OK 73083

3000 Ft. from East Line of Section

Contact Person Eric Boyce
Phone 413-348-6829

(Note: Locate well on Section Plat on reverse side)

CONTRACTOR: License # 4541

Nearest lease or unit boundary line 990 feet

Name Tracer Service Company, Inc.

County Woodson

City/State Route 1, Box 46A, LaHarpe, KS 66751

Lease Name J. Stabler Well # W-1

Well Drilled For: Well Class: Type Equipment:

Ground surface elevation na feet MSL

___ Oil ___ SWD ☒ Infield ☒ Mud Rotary

Domestic well within 330 feet: _____ yes ☒ no

___ Gas ___ Inj ___ Pool Ext. ___ Air Rotary

Municipal well within one mile: _____ yes ☒ no

___ OWWO ___ Expl ___ Wildcat ___ Cable

Surface pipe by Alternate: 1 ___ 2 ☒ ___

If OWWO: old well info as follows: wtr. Sup. X

Depth to bottom of fresh water 25 feet

Operator

Depth to bottom of usable water 150 feet

Well Name

Surface pipe planned to be set 150 feet

Comp Date Old Total Depth

Projected Total Depth 700 feet

I certify that well will comply with K.S.A. 55-101, et seq., plus eventually plugging hole to KCC specifications.

Formation Kansas City

_____ cementing will be done immediately upon setting production casing

Date 12/31/85. Signature of Operator or Agent _____ Title as agent

For KCC Use:

Conductor Pipe Required feet; Minimum Surface Pipe Required feet per Alt. 1 (2)

This Authorization Expires 7-1-86 Approved By _____

Must be filed with the K.C.C. five (5) days prior to commencing well
This card void if drilling not started within six (6) months of date received by K.C.C.


RECEIVED
STATE CORPORATION COMMISSION

DEC 31 1985

CONSERVATION DIVISION

12-31-85

A Regular Section of Land
1 Mile = 5,280 Ft.

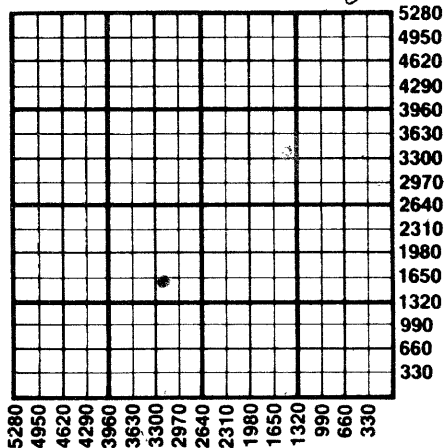

Important procedures to follow:

1. Notify District office before setting surface casing.
2. Set surface casing by circulating cement to the top.
3. File completion forms ACO-1 with K.C.C. within 90 days of well completion, following instructions on ACO-1, side 1, and including copies of wireline logs.
4. Notify District office 48 hours prior to old well workover or re-entry.
5. Prior to filing Intent, prepare a proposed plugging plan in case well is D & A, then obtain approval of plan when calling district office prior to setting surface pipe.
6. Submit plugging report (CP-4) to K.C.C. after plugging is completed.
7. Obtain an approved injection docket number before disposing of salt water.
8. Notify K.C.C. within 10 days when injection commences or terminates.
9. If an alternate 2 completion, cement in the production pipe from below any usable water to surface within 120 days of spud date.

State Corporation Commission of Kansas
Conservation Division
200 Colorado Derby Building
Wichita, Kansas 67202
(316) 263-3238