

CARD MUST BE TYPED

State of Kansas

CARD MUST BE SIGNED

NOTICE OF INTENTION TO DRILL

(see rules on reverse side)

Expected Spud Date..... 5..... 15..... 1988
month day year

API Number 15-003-22,900-00-00

OPERATOR: License # 6004
Name CALDWELL ENTERPRISES
Address 201 W. 4th
City/State/Zip Garnett, Kansas 66032
Contact Person Glenn Caldwell
Phone (913) 448-3578

East
NW NW NE Sec. 18 Twp. 21 S, Rg. 20 West
5115 Ft. from South Line of Section
2340 Ft. from East Line of Section

(Note: Locate well on Section Plat on reverse side)

CONTRACTOR: License # 5820
Name Kent Drilling Co.
City/State Garnett, Kansas 66032

Nearest lease or unit boundary line 165 feet
County ANDERSON
Lease Name CHARLES MELCHER Well # 1-A

Well Drilled For: Well Class: Type Equipment:
 Oil Storage Infield Mud Rotary
 Gas Inj Pool Ext. Air Rotary
 OWWO Expl Wildcat Cable

Ground surface elevation feet MSL
Domestic well within 330 feet: ___yes no
Municipal well within one mile: ___yes no
Depth to bottom of fresh water..... 0
Depth to bottom of usable water 125
Surface pipe by Alternate: 1 ___ 2
Surface pipe planned to be set 20
Conductor pipe required None
Projected Total Depth 870 feet
Formation Squirrel

If OWWO: old well info as follows:

Operator
Well Name
Comp Date Old Total Depth.....

I certify that well will comply with K.S.A. 55-101, et seq., plus eventually plugging hole to KCC specifications.

Date 5-10-88 Signature of Operator or Agent *Frank Dinger* Title Agent

For KCC Use:

Conductor Pipe Required feet; Minimum Surface Pipe Required 20 feet per Alt. (2)
This Authorization Expires 11-10-88 Approved By RCH 5-10-88


EFFECTIVE DATE: 5-15-88

Must be filed with the K.C.C. five (5) days prior to commencing well
This card void if drilling not started within six (6) months of date received by K.C.C.

Important procedures to follow:

1. Notify District office before setting surface casing.
2. Set surface casing by circulating cement to the top.
3. File completion forms ACO-1 with K.C.C. within 120 days of well spud date, following instructions on ACO-1, side 1, and including copies of wireline logs.
4. Notify District office 48 hours prior to old well workover or re-entry.
5. Prior to filing Intent, prepare a proposed plugging plan in case well is D & A, then obtain approval of plan when calling district office prior to setting surface pipe.
6. Submit plugging report (CP-4) to K.C.C. after plugging is completed.
7. Obtain an approved injection docket number before disposing of salt water.

A Regular Section of Land 1 Mile = 5,280 Ft.

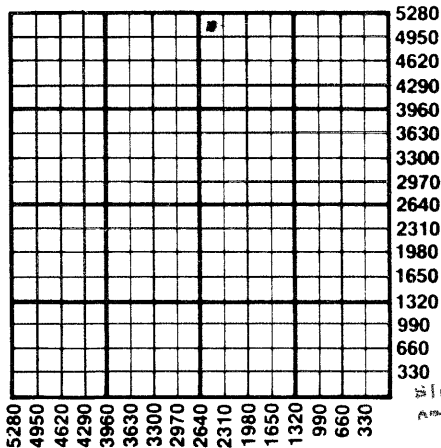

8. Notify K.C.C. within 10 days when injection commences or termi-

9. If an alternate 2 completion, cement in the production pipe from any usable water to surface within 120 days of spud date.

RECEIVED
MAY 10 1988
05-10-88
CONSERVATION DIVISION
Wichita, Kansas

State Corporation Commission of Kansas
Conservation Division
200 Colorado Derby Building
Wichita, Kansas 67202-1212
(316) 263-3238