

CARD MUST BE TYPED

State of Kansas
NOTICE OF INTENTION TO DRILL
(see rules on reverse side)

CORRECTION 7-23-84
CARD MUST BE SIGNED

Starting Date:2.....25.....84.....
month day year

API Number 15207-24728-0000

OPERATOR: License # 6807
Name Oil Drillers & Dev.
Address 7939 S.W. 29th
City/State/Zip Topeka, Kansas
Contact Person Dr. Jerry Feagan
Phone 913-354-9591

* SE-SW-NW-NE Sec .12. Twp .24. S, Rge .16. East
(location) West

* 4125 Ft North from Southeast Corner of Section

* 2475 Ft West from Southeast Corner of Section

(Note: Locate well on Section Plat on reverse side)

CONTRACTOR: License # 5367
Name Double "L" Drilling *
City/State WAS: Oil Drillers & Developers

Nearest lease or unit boundary line660..... feet.

County Woodson

Lease Name West Maher Well# 7

Domestic well within 330 feet: yes no

Municipal well within one mile: yes no

Well Drilled For: Well Class: Type Equipment:
 Oil Swd Infield Mud Rotary
 Gas Inj Pool Ext. Air Rotary
 OWWO Expl Wilcat Cable

Depth to Bottom of fresh water46..... feet

Lowest usable water formation

Depth to Bottom of usable water150..... feet

Surface pipe by Alternate: 1 2

Surface pipe to be set40..... feet

Conductor pipe if any required

Ground surface elevation feet MSL

This Authorization Expires 8/24/84

Approved By 2/24/84

If OWWO: old well info as follows:

Operator

Well Name

Comp Date Old Total Depth

Projected Total Depth 1016 * WAS: 1000 feet

Projected Formation at TD

Expected Producing Formations

I certify that we will comply with K.S.A. 55-101, et seq., plus eventually plugging hole to K.C.C. specifications.

Date JUL 12 1984

* WAS: NW/4 Signature of Operator or Agent

1155 FNL
105 FWL

Tom W. Stander Title
Tom W. Stander

Agent

Must be filed with the K.C.C. five (5) days prior to commencing well
This card void if drilling not started within six (6) months of date received by K.C.C.


RECEIVED
STATE CORPORATION COMMISSION
7-18-84
JUL 18 1984

Important procedures to follow :

CONSERVATION DIVISION

1. Notify District office before setting surface casing. Wichita, Kansas
2. Set surface casing by circulating cement to the top.
3. File completion forms ACO-1 with K.C.C. within 90 days of well completion, following instructions on ACO-1, side 1, and including copies of wireline logs.
4. Notify District office 48 hours prior to old well workover or re-entry.
5. Prior to plugging, prepare a plugging plan, then obtain agreement from the appropriate district office for an approved plugging plan.
6. Submit plugging report (CP-4) to K.C.C. after plugging is completed.
7. Obtain an approved injection docket number before disposing of salt water.
8. Notify K.C.C. within 10 days when injection commences or terminates.
9. If an alternate 2 completion, cement in the production pipe from below any usable water to surface within 120 days of spud date.

**A Regular Section of Land
1 Mile = 5,280 Ft.**

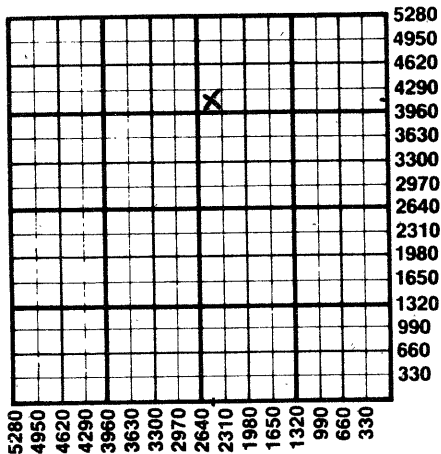

State Corporation Commission of Kansas
Conservation Division
200 Colorado Derby Building
Wichita, Kansas 67202
(316) 263-3238