

CARD MUST BE TYPED

State of Kansas  
**NOTICE OF INTENTION TO DRILL**  
(see rules on reverse side)

CARD MUST BE SIGNED

Starting Date: 3-28-84  
month day year

API Number 15- 207-24764 - CORRECTION  
7-23-84  
\* NW/SE/NW/NE. Sec . 12 Twp 24 . S, Rge 16.  East  
00-00  West

OPERATOR: License # 6807  
Name Oil Drillers & Dev.  
Address 7939 S.W. 29th  
City/State/Zip Topeka, Kansas 66614  
Contact Person Dr. Jerry Feagan  
Phone 913-354-9591

\* 4155 Ft North from Southeast Corner of Section  
\* 1815 Ft West from Southeast Corner of Section  
(Note: Locate well on Section Plat on reverse side)

CONTRACTOR: License #  
Name same as above  
City/State

Nearest lease or unit boundary line 660 feet.  
County Woodson  
Lease Name West Maher Well# 12

Well Drilled For: Well Class: Type Equipment:  
 Oil  Swd  Infield  Mud Rotary  
 Gas  Inj  Pool Ext.  Air Rotary  
 OWWO  Expl  Wildcat  Cable

Domestic well within 330 feet:  yes  no  
Municipal well within one mile:  yes  no

If OWWO: old well info as follows:  
Operator  
Well Name  
Comp Date \* Old Total Depth  
Projected Total Depth \* 1342 WAS: 1350 feet  
Projected Formation at TD  
Expected Producing Formations

Depth to Bottom of fresh water 46 feet  
Lowest usable water formation  
Depth to Bottom of usable water 150 feet  
Surface pipe by Alternate: 1  2   
Surface pipe to be set 40 feet  
Conductor pipe if any required  
Ground surface elevation feet MSL  
This Authorization Expires 9/23/84  
Approved By 3-23-84

I certify that we will comply with K.S.A. 55-101, et seq., plus eventually plugging hole to K.C.C. specifications.

Date JUL 12 1984  
Signature of Operator or Agent Tom W. Standen  
\* WAS: NW/4 825 FNL, 825 FNL Tom W. Standen

Agent

Must be filed with the K.C.C. five (5) days prior to commencing well  
This card void if drilling not started within six (6) months of date received by K.C.C. STATE CORPORATION COMMISSION

RECEIVED

7-18-84

JUL 18 1984


**Important procedures to follow:**

CONSERVATION DIVISION

Wichita, Kansas

1. Notify District office before setting surface casing.
2. Set surface casing by circulating cement to the top.
3. File completion forms ACO-1 with K.C.C. within 90 days of well completion, following instructions on ACO-1, side 1, and including copies of wireline logs.
4. Notify District office 48 hours prior to old well workover or re-entry.
5. Prior to plugging, prepare a plugging plan, then obtain agreement from the appropriate district office for an approved plugging plan.
6. Submit plugging report (CP-4) to K.C.C. after plugging is completed.
7. Obtain an approved injection docket number before disposing of salt water.
8. Notify K.C.C. within 10 days when injection commences or terminates.
9. If an alternate 2 completion, cement in the production pipe from below any usable water to surface within 120 days of spud date.

**A Regular Section of Land  
1 Mile = 5,280 Ft.**

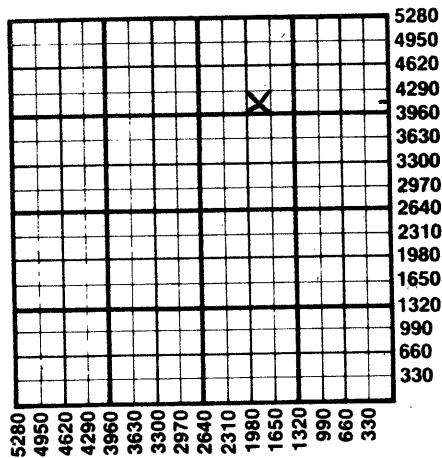

State Corporation Commission of Kansas  
Conservation Division  
200 Colorado Derby Building  
Wichita, Kansas 67202  
(316) 263-3238