

CARD MUST BE TYPED

State of Kansas
NOTICE OF INTENTION TO DRILL
(see rules on reverse side)

CARD MUST BE SIGNED

Starting Date: 3-30-84
month day year

API Number 15-207-~~24785~~ ^{-24765-CORRECTION} 06-007-23-84

OPERATOR: License # 6807.....
Name Oil Drillers & Dev.....
Address 7939 S.W. 29th.....
City/State/Zip Topeka, Kansas 66614.....
Contact Person Dr. Jerry Feagan.....
Phone 913-354-9591.....

* SE-NE-NW-NE (location) Sec .12. Twp .24. S, Rge .16. East West

CONTRACTOR: License #
Name same as above.....
City/State

* 4785... Ft North from Southeast Corner of Section
* 1485... Ft West from Southeast Corner of Section
(Note: Locate well on Section Plat on reverse side)

Well Drilled For: Well Class: Type Equipment:
 Oil Swd Infield Mud Rotary
 Gas Inj Pool Ext. Air Rotary
 OWWO Expl Wildcat Cable

Nearest lease or unit boundary line 330..... feet.
County Woodson.....
Lease Name West Maher Well# 13.....
Domestic well within 330 feet : yes no
Municipal well within one mile : yes no

If OWWO: old well info as follows:
Operator
Well Name
Comp Date Old Total Depth
Projected Total Depth 1323 WAS 1350 feet
Projected Formation at TD
Expected Producing Formations

Depth to Bottom of fresh water 46..... feet
Lowest usable water formation
Depth to Bottom of usable water 150..... feet
Surface pipe by Alternate : 1 2
Surface pipe to be set 40..... feet
Conductor pipe if any required feet
Ground surface elevation feet MSL
This Authorization Expires 9/23/84
Approved By 3-23-84

I certify that we will comply with K.S.A. 55-101, et seq., plus eventually plugging hole to K.C.C. specifications.

Date JUL 12 1984
Signature of Operator or Agent *Tom W. Stander*
WAS 3 NW/4 1825 FNL, 165 FWL Tom W. Stander

Agent

Must be filed with the K.C.C. five (5) days prior to commencing well
 This card void if drilling not started within six (6) months of date received by K.C.C.

RECEIVED

STATE CORPORATION COMMISSION

7-18-84
 JUL 18 1984


Important procedures to follow :

CONSERVATION DIVISION

1. Notify District office before setting surface casing. Wichita, Kansas
2. Set surface casing by circulating cement to the top.
3. File completion forms ACO-1 with K.C.C. within 90 days of well completion, following instructions on ACO-1, side 1, and including copies of wireline logs.
4. Notify District office 48 hours prior to old well workover or re-entry.
5. Prior to plugging, prepare a plugging plan, then obtain agreement from the appropriate district office for an approved plugging plan.
6. Submit plugging report (CP-4) to K.C.C. after plugging is completed.
7. Obtain an approved injection docket number before disposing of salt water.
8. Notify K.C.C. within 10 days when injection commences or terminates.
9. If an alternate 2 completion, cement in the production pipe from below any usable water to surface within 120 days of spud date.

A Regular Section of Land

1 Mile = 5,280 Ft.

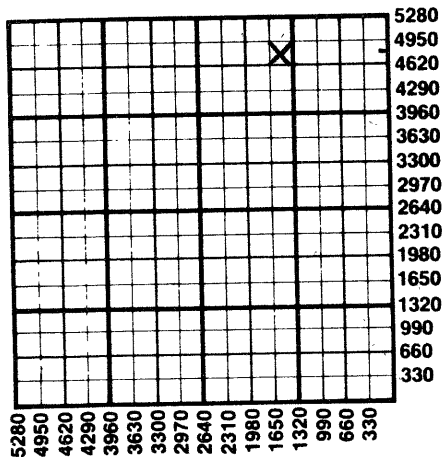

State Corporation Commission of Kansas
 Conservation Division
 200 Colorado Derby Building
 Wichita, Kansas 67202
 (316) 263-3238