

CARD MUST BE TYPED

State of Kansas
NOTICE OF INTENTION TO DRILL
(see rules on reverse side)

CARD MUST BE SIGNED

Starting Date: 3-21-84
month day year

OPERATOR: License # 6807
Name Oil Drillers & Dev.
Address 7939 S.W. 29th
City/State/Zip Topeka, Kansas 66614
Contact Person Dr. Jerry Feagan
Phone 913-354-9591

CONTRACTOR: License #
Name same as above
City/State

Well Drilled For: Well Class: Type Equipment:
 Oil Swd Infield Mud Rotary
 Gas Inj Pool Ext. Air Rotary
 OWWO Expl Wildcat Cable

If OWWO: old well info as follows:

Operator
Well Name
Comp Date * Old Total Depth
Projected Total Depth * 1343 W.S.: 1350 feet
Projected Formation at TD
Expected Producing Formations

API Number 15- 207-~~24755~~ ^{24,740-00-09} 2ND CONVECTION 7-23-84
* NE/NW/SW/NE (location) Sec 12.. Twp .24. S, Rge ..16 East West

* 3795 Ft North from Southeast Corner of Section
* 2145... Ft West from Southeast Corner of Section
(Note: Locate well on Section Plat on reverse side)

Nearest lease or unit boundary line 660 feet.
County Woodson

Lease Name West Maher Well# 10

Domestic well within 330 feet : yes no
Municipal well within one mile : yes no

Depth to Bottom of fresh water 86 feet
Lowest usable water formation

Depth to Bottom of usable water 150 feet

Surface pipe by Alternate : 1 2
Surface pipe to be set 40 feet
Conductor pipe if any required feet
Ground surface elevation feet MSL

This Authorization Expires 9/6/84
Approved By 3/16/84

I certify that we will comply with K.S.A. 55-101, et seq., plus eventually plugging hole to K.C.C. specifications.


Date JUL 12 1984 Signature of Operator or Agent Tom W. Stander Title Agent
* WQS: 825 FNL, 495 FNL, NW/4 Tom W. Stander

Must be filed with the K.C.C. five (5) days prior to commencing well
 This card void if drilling not started within six (6) months of date received by K.C.C.

7-18-84
 RECEIVED

Important procedures to follow STATE CORPORATION COMMISSION

A Regular Section of Land
 1 Mile = 5,280 Ft.

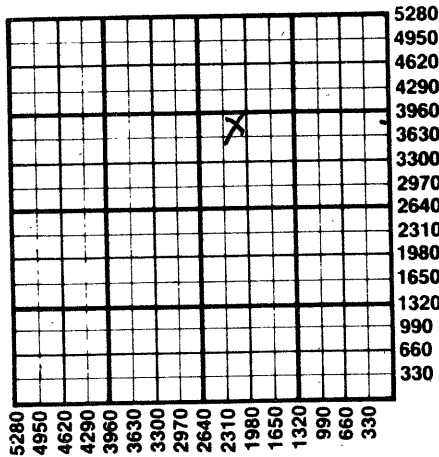

1. Notify District office before setting surface casing.
2. Set surface casing by circulating cement to the top.
3. File completion forms ACO-1 with K.C.C. within 90 days of completion, following instructions on ACO-1, side 1, and including copies of wireline logs.
4. Notify District office 48 hours prior to old well workover or re-entry.
5. Prior to plugging, prepare a plugging plan, then obtain agreement from the appropriate district office for an approved plugging plan.
6. Submit plugging report (CP-4) to K.C.C. after plugging is completed.
7. Obtain an approved injection docket number before disposing of salt water.
8. Notify K.C.C. within 10 days when injection commences or terminates.
9. If an alternate 2 completion, cement in the production pipe from below any usable water to surface within 120 days of spud date.

JUL 18 1984

CONSERVATION DIVISION
 Wichita, Kansas

State Corporation Commission of Kansas
 Conservation Division
 200 Colorado Derby Building
 Wichita, Kansas 67202
 (316) 263-3238