

CARD MUST BE TYPED

State of Kansas
NOTICE OF INTENTION TO DRILL
(see rules on reverse side)

2ND Correction 7-23-84
CARD MUST BE SIGNED

Starting Date: 3-28-1984
month day year

API Number 15-207-24777-00-00

OPERATOR: License # 6807
Name Oil Drillers & Dev. Inc.
Address 7939 S.W. 29th
City/State/Zip Topeka, Ks: 66614
Contact Person Dr. Jerry Feagan
Phone 913-354-9590 (ext. Irene)

NE
.....
(location) Sec 12. Twp 24. S, Rge 16. East
 West

* 4785 Ft North from Southeast Corner of Section
* 165 Ft WSW from Southeast Corner of Section
(Note: Locate well on Section Plat on reverse side)

CONTRACTOR: License #
Name Same as above
City/State

Nearest lease or unit boundary line 165 feet.
County Woodson
Lease Name Beck-Mason Farm Well# 1

Well Drilled For: Well Class: Type Equipment:
 Oil Swd Infield Mud Rotary
 Gas Inj Pool Ext. Air Rotary
 OWWO Expl Wildcat Cable

Domestic well within 330 feet: yes no
Municipal well within one mile: yes no

Depth to Bottom of fresh water 46 feet
Lowest usable water formation

Depth to Bottom of usable water 150 feet

Surface pipe by Alternate: 1 2
Surface pipe to be set 40 feet

Conductor pipe if any required feet
Ground surface elevation feet MSL

This Authorization Expires 9/28/84
Approved By 3-28-84

I certify that we will comply with K.S.A. 55-101, et seq., plus eventually plugging hole to K.C.C. specifications.

Date 3/28/84 Signature of Operator or Agent Tom W. Stander Title Agent


JUL 12 1984
KAS: 495' FNL 180' FEL

Must be filed with the K.C.C. five (5) days prior to commencing well
This card void if drilling not started within six (6) months of date received by K.C.C.

RECEIVED
STATE CORPORATION COMMISSION

7-18-84 JUL 18 1984
Important procedures to follow:

A Regular Section of Land
1 Mile = 5,280 Ft.

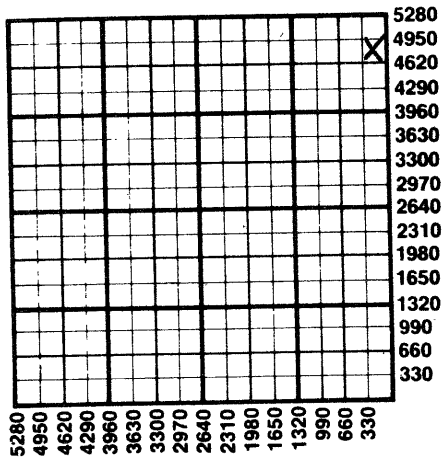

1. Notify District office before setting surface casing. **CONSERVATION DIVISION**
Wichita, Kansas
2. Set surface casing by circulating cement to the top.
3. File completion forms ACO-1 with K.C.C. within 90 days of well completion, following instructions on ACO-1, side 1, and including copies of wireline logs.
4. Notify District office 48 hours prior to old well workover or re-entry.
5. Prior to plugging, prepare a plugging plan, then obtain agreement from the appropriate district office for an approved plugging plan.
6. Submit plugging report (CP-4) to K.C.C. after plugging is completed.
7. Obtain an approved injection docket number before disposing of salt water.
8. Notify K.C.C. within 10 days when injection commences or terminates.
9. If an alternate 2 completion, cement in the production pipe from below any usable water to surface within 120 days of spud date.

State Corporation Commission of Kansas
Conservation Division
200 Colorado Derby Building
Wichita, Kansas 67202
(316) 263-3238