

CARD MUST BE TYPED

State of Kansas
NOTICE OF INTENTION TO DRILL
(see rules on reverse side)

2ND Correction 7-23-84
CARD MUST BE SIGNED

Starting Date: 4-27-84
month day year

API Number 15-207-24782 - 00-00

OPERATOR: License # 6807

NEW 4
..... Sec 12. Twp 24. S, Rge 16. East
 West
(location)

Name Oil Drillers & Dev., Inc.

Address 7939 S.W. 29th

City/State/Zip Topeka, Kansas 66614

Contact Person Dr. Jerry Feagan

Phone 913-354-9591 (ext. Irene)

CONTRACTOR: License #

Name Same as above

City/State

Well Drilled For: Well Class: Type Equipment:

- Oil Swd Infield Mud Rotary
- Gas Inj Pool Ext. Air Rotary
- OWWO Expl Wildcat Cable

** 42701*
..... Ft North from Southeast Corner of Section
..... Ft West from Southeast Corner of Section
(Note: Locate well on Section Plat on reverse side)

Nearest lease or unit boundary line 165 feet.

County Woodson

Lease Name Beck-Mason Farm Well# 2

Domestic well within 330 feet: yes no

Municipal well within one mile: yes no

Depth to Bottom of fresh water 46 feet

Lowest usable water formation

Depth to Bottom of usable water 150 feet

Surface pipe by Alternate: 1 2

Surface pipe to be set 40 feet

Conductor pipe if any required

Ground surface elevation feet MSL

This Authorization Expires 10/4/84

Approved By 4-4-84

I certify that we will comply with K.S.A. 55-101, et seq., plus eventually plugging hole to K.C.C. specifications.

Date 4/27/84
Signature of Operator or Agent

Tom W. Stander
Tom W. Stander
Agent

JUL 12 1984

WAS 660' FNL, 105 FNL


Must be filed with the K.C.C. five (5) days prior to commencing well
 This card void if drilling not started within six (6) months of date received by K.C.C.

RECEIVED
 STATE CORPORATION COMMISSION

7-18-84
 JUL 18 1984

Important procedures to follow:

A Regular Section of Land
1 Mile = 5,280 Ft.

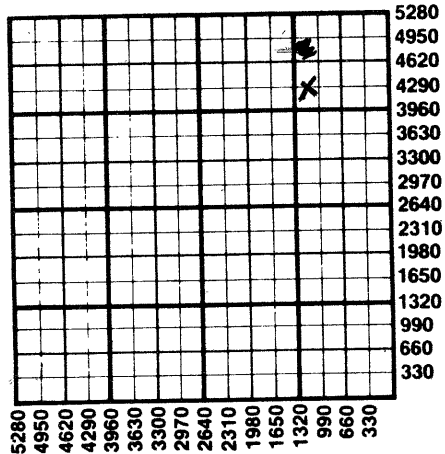

1. Notify District office before setting surface casing.
2. Set surface casing by circulating cement to the top.
3. File completion forms ACO-1 with K.C.C. within 90 days of well completion, following instructions on ACO-1, side 1, and including copies of wireline logs.
4. Notify District office 48 hours prior to old well workover or re-entry.
5. Prior to plugging, prepare a plugging plan, then obtain agreement from the appropriate district office for an approved plugging plan.
6. Submit plugging report (CP-4) to K.C.C. after plugging is completed.
7. Obtain an approved injection docket number before disposing of salt water.
8. Notify K.C.C. within 10 days when injection commences or terminates.
9. If an alternate 2 completion, cement in the production pipe from below any usable water to surface within 120 days of spud date.

State Corporation Commission of Kansas
 Conservation Division
 200 Colorado Derby Building
 Wichita, Kansas 67202
 (316) 263-3238