

CARD MUST BE TYPED

State of Kansas  
**NOTICE OF INTENTION TO DRILL**  
(see rules on reverse side)

CARD MUST BE SIGNED

Starting Date: ..... 4-5-84 .....  
month day year

OPERATOR: License # 6807  
Name Oil Drillers & Dev., Inc.

Address 7939 S.W. 29th

City/State/Zip Topeka, Kansas 66614

Contact Person Dr. Jerry Feagan

Phone 913-354-9591 (ext. 388 Irene)

CONTRACTOR: License #

Name same as above

City/State

Well Drilled For: Well Class: Type Equipment:

- Oil  Swd  Infield  Mud Rotary
- Gas  Inj  Pool Ext.  Air Rotary
- OWWO  Expl  Wildcat  Cable

If OWWO: old well info as follows:

Operator

Well Name

Comp Date Old Total Depth

Projected Total Depth 1350 feet

Projected Formation at TD

Expected Producing Formations

API Number 15-207-24783-CORRECTION  
NEY4 00-00 7-23-84  
..... Sec 12 Twp 24 S, Rge 16  East  
..... (location)  West

\* 4950 Ft North from Southeast Corner of Section  
\* 1120 Ft West from Southeast Corner of Section  
(Note: Locate well on Section Plat on reverse side)

Nearest lease or unit boundary line 165 feet

County Woodson

Lease Name Beck-Mason Farm Well# 3

Domestic well within 330 feet:  yes  no

Municipal well within one mile:  yes  no

Depth to Bottom of fresh water 46 feet

Lowest usable water formation

Depth to Bottom of usable water 150 feet

Surface pipe by Alternate: 1  2

Surface pipe to be set 40 feet

Conductor pipe if any required

Ground surface elevation

This Authorization Expires 10/4/84

Approved By 4-4-84

I certify that we will comply with K.S.A. 55-101, et seq., plus eventually plugging hole to K.C.C. specifications.

Date JUL 12 1984  
Signature of Operator or Agent  
ALWAS 165' FNL, 1155 FBL


Tom W. Stander  
Tom W. Stander Title Agent

Must be filed with the K.C.C. five (5) days prior to commencing well  
 This card void if drilling not started within six (6) months of date received by K.C.C.

7-18-84 RECEIVED  
 STATE CORPORATION COMMISSION

Important procedures to follow JUL 18 1984

**A Regular Section of Land**  
**1 Mile = 5,280 Ft.**

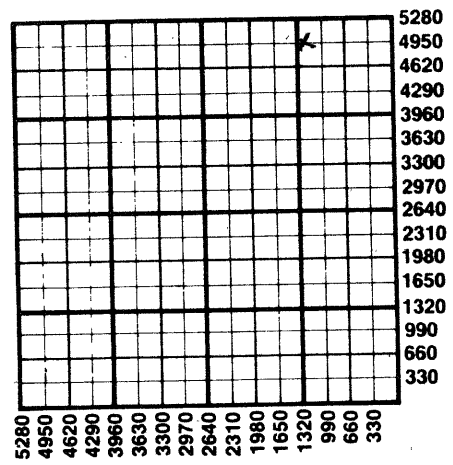

1. Notify District office before setting surface casing.
2. Set surface casing by circulating cement to the top.
3. File completion forms ACO-1 with K.C.C. within 90 days of well completion, following instructions on ACO-1, side 1, and including copies of wireline logs.
4. Notify District office 48 hours prior to old well workover or re-entry.
5. Prior to plugging, prepare a plugging plan, then obtain agreement from the appropriate district office for an approved plugging plan.
6. Submit plugging report (CP-4) to K.C.C. after plugging is completed.
7. Obtain an approved injection docket number before disposing of salt water.
8. Notify K.C.C. within 10 days when injection commences or terminates.
9. If an alternate 2 completion, cement in the production pipe from below any usable water to surface within 120 days of spud date.

CONSERVATION DIVISION  
 Wichita, Kansas

State Corporation Commission of Kansas  
 Conservation Division  
 200 Colorado Derby Building  
 Wichita, Kansas 67202  
 (316) 263-3238