

CARD MUST BE TYPED

State of Kansas
NOTICE OF INTENTION TO DRILL
(see rules on reverse side)

CARD MUST BE SIGNED

Starting Date: July 20, 1985
month day year 11:20

API Number 15- 121-26,611-00-00

OPERATOR: License # 7167
Name ~~XXXXXXXXXX~~ *Leach Well Palling*
Address Route 2, Box 27
City/State/Zip Osawatomie, KS 66064
Contact Person Brad Leach
Phone 913 775 4724

app. C NE NE East
(location) Sec 12 Twp 19 S, Rge 24 West

CONTRACTOR: License #
Name Unknown
City/State

4340 Ft North from Southeast Corner of Section
660 Ft West from Southeast Corner of Section
(Note: Locate well on Section Plat on reverse side)

Well Drilled For: Well Class: Type Equipment:
 Oil Swd Infield Mud Rotary
 Gas Inj Pool Ext. Air Rotary
 OWWO Expl Wildcat Cable

Nearest lease or unit boundary line 660 feet.
County Miami
Lease Name Vantyle Well# 13

Domestic well within 330 feet: yes no
Municipal well within one mile: yes no

If OWWO: old well info as follows:
Operator
Well Name
Comp Date Old Total Depth
Projected Total Depth 280 feet
Projected Formation at TD Peru
Expected Producing Formations

Depth to Bottom of fresh water 50 feet
Lowest usable water formation Kansas City Group
Depth to Bottom of usable water 200 feet
Surface pipe by Alternate: 1 2
Surface pipe to be set 20 feet
Conductor pipe if any required feet
Ground surface elevation feet MSL
This Authorization Expires 1-19-86
Approved By 7-19-85 *RCH*

I certify that we will comply with K.S.A. 55-101, et seq., plus eventually plugging hole to K.C.C. specifications.

Date 7/19/85 Signature of Operator or Agent *Clairie Durham* Title as agent

RCH for KOHE

Must be filed with the K.C.C. five (5) days prior to commencing well
 This card void if drilling not started within six (6) months of date received by K.C.C.

RECEIVED
 STATE CORPORATION COMMISSION
 K.C. 07-19-85


JUL 19 1985

CONSERVATION DIVISION
 Wichita, Kansas

Important procedures to follow:

A Regular Section of Land
 1 Mile = 5,280 Ft.

1. Notify District office before setting surface casing.
2. Set surface casing by circulating cement to the top.
3. File completion forms ACO-1 with K.C.C. within 90 days of well completion, following instructions on ACO-1, side 1, and including copies of wireline logs.
4. Notify District office 48 hours prior to old well workover or re-entry.
5. Prior to plugging, prepare a plugging plan, then obtain agreement from the appropriate district office for an approved plugging plan.
6. Submit plugging report (CP-4) to K.C.C. after plugging is completed.
7. Obtain an approved injection docket number before disposing of salt water.
8. Notify K.C.C. within 10 days when injection commences or terminates.
9. If an alternate 2 completion, cement in the production pipe from below any usable water to surface within 120 days of spud date.

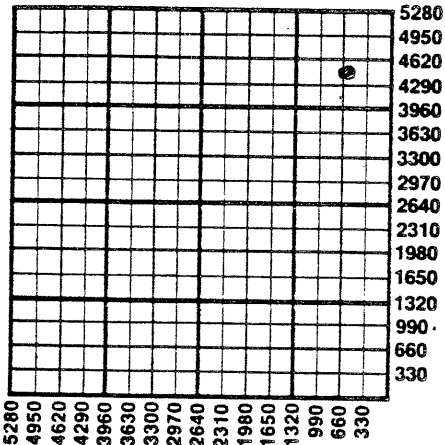

State Corporation Commission of Kansas
 Conservation Division
 200 Colorado Derby Building
 Wichita, Kansas 67202
 (316) 263-3238