

CARD MUST BE TYPED

State of Kansas  
**NOTICE OF INTENTION TO DRILL**

CARD MUST BE SIGNED

Starting Date: May 29 1985  
month day year

API Number 15- 207-25,292-0000

OPERATOR: License # 5096  
Name James E. Russell Petr., Inc.  
Address 536 N. Highland  
City/State/Zip Chanute, Kansas 66720  
Contact Person G. Bob Barnett  
Phone 316-431-0755

SE/4 NW/4 NW/4 Sec 11 Twp 24 S, Rge 16  East  
(location)  West

4270 Ft North from Southeast Corner of Section  
4290 Ft West from Southeast Corner of Section  
(Note: Locate well on Section Plat on reverse side)

CONTRACTOR: License # 6440  
Name Target Resources, Inc.  
City/State P.O. Box 34, Piqua, KS 66721

Nearest lease or unit boundary line 990 feet.  
County Woodson  
Lease Name Strahm Well# 0-13

Domestic well within 330 feet:  yes  no  
Municipal well within one mile:  yes  no

Well Drilled For: Well Class: Type Equipment:  
 Oil  Swd  Infield  Mud Rotary  
 Gas  Inj  Pool Ext.  Air Rotary  
 OWWO  Expl  Wildcat  Cable

Depth to Bottom of fresh water 150<sup>?</sup> 100 RCH feet  
Lowest usable water formation unknown  
Depth to Bottom of usable water 150 feet  
Surface pipe by Alternate: 1  2   
Surface pipe to be set 40 feet  
Conductor pipe if any required none feet  
Ground surface elevation 1055.0 feet MSL  
This Authorization Expires 11-30-85  
Approved By 5-30-85 R.C.

If OWWO: old well info as follows:

Operator .....  
Well Name .....  
Comp Date ..... Old Total Depth .....  
Projected Total Depth 1070 feet  
Projected Formation at TD Squirrel  
Expected Producing Formations Squirrel

I certify that we will comply with K.S.A. 55-101, et seq., plus eventually plugging hole to K.C.C. specifications.

RCH for KCH

Date 5-29-85 Signature of Operator or Agent Bradley Kouch Title Enginner


Must be filed with the K.C.C. five (5) days prior to commencing well  
This card void if drilling not started within six (6) months of date received by K.C.C.

RECEIVED  
STATE CORPORATION COMMISSION  
MAY 30 1985  
5-30-85  
CONSERVATION DIVISION  
Wichita, Kansas

**Important procedures to follow:**

1. Notify District office before setting surface casing.
2. Set surface casing by circulating cement to the top.
3. File completion forms ACO-1 with K.C.C. within 90 days of well completion, following instructions on ACO-1, side 1, and including copies of wireline logs.
4. Notify District office 48 hours prior to old well workover or re-entry.
5. Prior to plugging, prepare a plugging plan, then obtain agreement from the appropriate district office for an approved plugging plan.
6. Submit plugging report (CP-4) to K.C.C. after plugging is completed.
7. Obtain an approved injection docket number before disposing of salt water.
8. Notify K.C.C. within 10 days when injection commences or terminates.
9. If an alternate 2 completion, cement in the production pipe from below any usable water to surface within 120 days of spud date.

**A Regular Section of Land**  
**1 Mile = 5,280 Ft.**

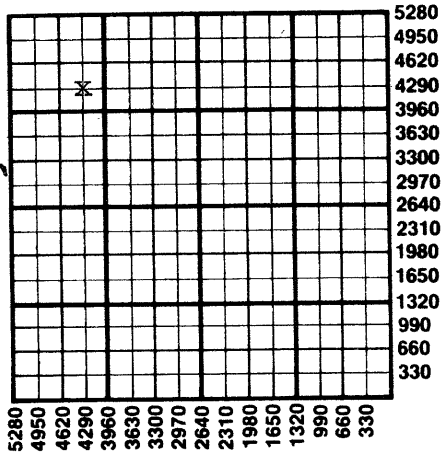

State Corporation Commission of Kansas  
Conservation Division  
200 Colorado Derby Building  
Wichita, Kansas 67202  
(316) 263-3238