

CARD MUST BE TYPED

State of Kansas
NOTICE OF INTENTION TO DRILL
(see rules on reverse side)

CARD MUST BE SIGNED

Starting Date: Dec. 17, 1985
month day year

API Number 15- 207-25,429-00-00

OPERATOR: License # 6443
Name Lewis Long (~~Long Type Oil Co.~~)
Address Box 110
City/State/Zip Hamilton Kansas 66853
Contact Person Lewis Long
Phone 316678 3819

NE $\frac{1}{4}$ (location) Sec 33 Twp 23 S, Rge 16 East West

3890 Ft North from Southeast Corner of Section
1500 ft. Ft West from Southeast Corner of Section
(Note: Locate well on Section Plat on reverse side)

CONTRACTOR: License # 5676
Name EDCO Drilg. Co. Inc.
City/State Box 645 El Dorado, Kansas 67042

Nearest lease or unit boundary line 1250 feet.
County Woodson
Lease Name Fuller Well# 20

Well Drilled For: Well Class: Type Equipment:
 Oil Swd Infield Mud Rotary
 Gas Inj Pool Ext. Air Rotary
 OWWO Expl Wildcat Cable

Domestic well within 330 feet: yes no
Municipal well within one mile: yes no

If OWWO: old well info as follows:
Operator
Well Name
Comp Date Old Total Depth
 Projected Total Depth 1100 feet
Projected Formation at TD
Expected Producing Formations

Depth to Bottom of fresh water 40 feet
Lowest usable water formation 40 feet
Depth to Bottom of usable water 40 150 feet
Surface pipe by Alternate: 1 2
Surface pipe to be set 42 feet
Conductor pipe if any required feet
Ground surface elevation 1079 feet MSL
This Authorization Expires 6-13-86
Approved By 12-13-85

I certify that we will comply with K.S.A. 55-101, et seq., plus eventually plugging hole to K.C.C. specifications.

Date Dec. 12, 1985 Signature of Operator or Agent

Lewis C. Long


Title co-owner

R. C. [Signature]

Must be filed with the K.C.C. five (5) days prior to commencing well
This card void if drilling not started within six (6) months of date received by K.C.C.

Important procedures to follow :

**A Regular Section of Land
1 Mile = 5,280 Ft.**

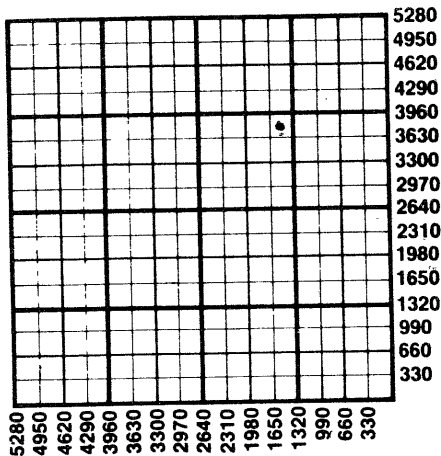

1. Notify District office before setting surface casing.
2. Set surface casing by circulating cement to the top.
3. File completion forms ACO-1 with K.C.C. within 90 days of well completion, following instructions on ACO-1, side 1, and including copies of wireline logs.
4. Notify District office 48 hours prior to old well workover or re-entry.
5. Prior to plugging, prepare a plugging plan, then obtain agreement from the appropriate district office for an approved plugging plan.
6. Submit plugging report (CP-4) to K.C.C. after plugging is completed.
7. Obtain an approved injection docket number before disposing of salt water.
8. Notify K.C.C. within 10 days when injection commences or terminates.
9. If an alternate 2 completion, cement in the production pipe from below any usable water to surface within 120 days of spud date.

State Corporation Commission of Kansas
Conservation Division
200 Colorado Derby Building
Wichita, Kansas 67202
(316) 263-3238