

CARD MUST BE TYPED

State of Kansas

CARD MUST BE SIGNED

NOTICE OF INTENTION TO DRILL

(see rules on reverse side)

Expected Spud Date.....8.....8.....1988.....
month day year

API Number 15- 121-26,936-00-00 ✓

OPERATOR: License # 5955.....

NE. SW NE Sec...2.. Twp.18.. S, Rg..21... ☒ East

Name Pioneer..... 3795..... Ft. from South Line of Section

Address Box 253..... 1815..... Ft. from East Line of Section

(Note: Locate well on Section Plat on reverse side)

City/State/Zip Osawatimie Kansas.....66064.....

Contact Person Paul Jackson.....

Phone 913.795.2586.....

CONTRACTOR: License # 6157.....

Nearest lease or unit boundary line ...1650..... feet

County Miami.....

Lease Name Pettitt..... Well # L...10..

Ground surface elevation N/A..... feet MSL

Domestic well within 330 feet: _____yes ☒noMunicipal well within one mile: _____yes ☒no

Depth to bottom of fresh water....62!.....

Depth to bottom of usable water 200!.....

Surface pipe by Alternate: _____1 2 ☒

Surface pipe planned to be set 21!.....

Conductor pipe required None.....

Projected Total Depth ...500!..... feet

Formation Squirrel.....

Well Drilled For: Well Class: Type Equipment:

☒ Oil _____ Storage ☒ Infield ☒ Mud Rotary

_____ Gas _____ Inj _____ Pool Ext. _____ Air Rotary

_____ OWWO _____ Expl _____ Wildcat _____ Cable

IF OWWO: old well info as follows:

Operator

Well Name

Comp Date..... Old Total Depth.....

I certify that well will comply with K.S.A. 55-101, et seq., plus eventually plugging hole to KCC specifications.

Date 7-28-1988 Signature of Operator or Agent Paul Jackson Title Contractor

For KCC Use:

Conductor Pipe Required feet; Minimum Surface Pipe Required 20' feet per Alt. ☒ (2)

This Authorization Expires 2-1-89 Approved By LKM 8-1-88


EFFECTIVE DATE: 8-6-88

Must be filed with the K.C.C. five (5) days prior to commencing well
This card void if drilling not started within six (6) months of date received by K.C.C.

Important procedures to follow:

1. Notify District office before setting surface casing.
2. Set surface casing by circulating cement to the top.
3. File completion forms ACO-1 with K.C.C. within 120 days of well spud date, following instructions on ACO-1, side 1, and including copies of wireline logs.
4. Notify District office 48 hours prior to old well workover or re-entry.
5. Prior to filing Intent, prepare a proposed plugging plan in case well is D & A, then obtain approval of plan when calling district office prior to setting surface pipe.
6. Submit plugging report (CP-4) to K.C.C. after plugging is completed.
7. Obtain an approved injection docket number before disposing of salt water.
8. Notify K.C.C. within 10 days when injection commences or terminate.
9. If an alternate 2 completion, cement in the production pipe from below any usable water to surface within 120 days of spud date.

A Regular Section of Land
1 Mile = 5,280 Ft.

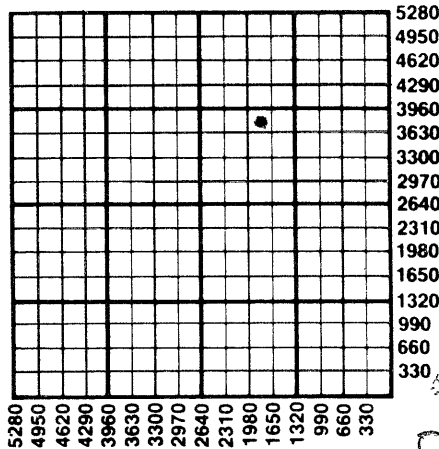

State Corporation Commission of Kansas
Conservation Division
200 Colorado Derby Building
Wichita, Kansas 67202-1212
(316) 263-3238