

CARD MUST BE TYPED

State of Kansas
NOTICE OF INTENTION TO DRILL
(see rules on reverse side)

CARD MUST BE SIGNED

Starting Date: 12 28 1984
month day year

API Number 15- 121-26,470-00-00

OPERATOR: License # 6038

NE/4 30 17 22 East
..... Sec Twp S, Rge West
(location)

Name Petroleum Production Corp.

Address Box 202

City/State/Zip Paola, Ks 66071

Contact Person Fred Green

Phone 913 878 3437

3025 Ft North from Southeast Corner of Section

825 Ft West from Southeast Corner of Section

(Note: Locate well on Section Plat on reverse side)

CONTRACTOR: License #

Nearest lease or unit boundary line 825 feet.

Name Company tools

County Miami

City/State

Lease Name Brown Well# 11

Well Drilled For: Well Class: Type Equipment:

- Oil Swd Infield Mud Rotary
- Gas Inj Pool Ext. Air Rotary
- OWWO Expl Wildcat Cable

Domestic well within 330 feet : yes no

Municipal well within one mile : yes no

If OWWO: old well info as follows:

Operator

Well Name

Comp Date Old Total Depth

Projected Total Depth 450 feet

Projected Formation at TD Peru

Expected Producing Formations

Depth to Bottom of fresh water 43 feet

Lowest usable water formation feet

Depth to Bottom of usable water 200 feet

Surface pipe by Alternate : 1 2

Surface pipe to be set 20 feet

Conductor pipe if any required feet

Ground surface elevation feet MSL

This Authorization Expires 6-27-85

Approved By RCH/ECC 12-27-84

I certify that we will comply with K.S.A. 55-101, et seq., plus eventually plugging hole to K.C.C. specifications.

12/27/84

Date Signature of Operator or Agent

E. Darben

Title as agent MHC/NOHE 12/27/84

Must be filed with the K.C.C. five (5) days prior to commencing well
 This card void if drilling not started within six (6) months of date received by K.C.C.

Wichita, Kansas


CONSERVATION DIVISION

12-27-84
 DEC 27 1984

A Regular Section of Land

STATE OF KANSAS

RECEIVED

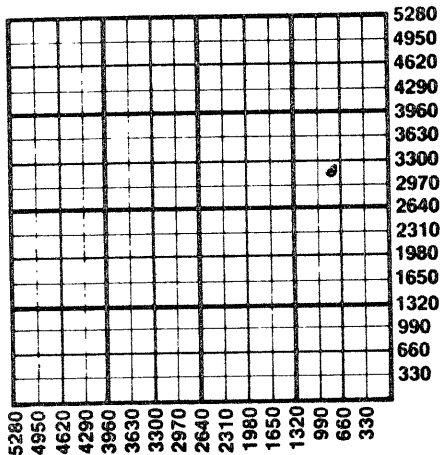

Important procedures to follow :

1. Notify District office before setting surface casing.
2. Set surface casing by circulating cement to the top.
3. File completion forms ACO-1 with K.C.C. within 90 days of well completion, following instructions on ACO-1, side 1, and including copies of wireline logs.
4. Notify District office 48 hours prior to old well workover or re-entry.
5. Prior to plugging, prepare a plugging plan, then obtain agreement from the appropriate district office for an approved plugging plan.
6. Submit plugging report (CP-4) to K.C.C. after plugging is completed.
7. Obtain an approved injection docket number before disposing of salt water.
8. Notify K.C.C. within 10 days when injection commences or terminates.
9. If an alternate 2 completion, cement in the production pipe from below any usable water to surface within 120 days of spud date.

State Corporation Commission of Kansas
 Conservation Division
 200 Colorado Derby Building
 Wichita, Kansas 67202
 (316) 263-3238