

CARD MUST BE TYPED

State of Kansas

CARD MUST BE SIGNED

NOTICE OF INTENTION TO DRILL

(see rules on reverse side)

Expected Spud Date..... Sept. 1 1987
month day year

API Number 15— 121-26,851-00-00

OPERATOR: License # 03518
Name Eastern Kansas Drilling, Inc.
Address 15155 England Drive
City/State/Zip Stanley, Kansas 66221
Contact Person Roger Stover
Phone 913-897-4169

C. NE Sec. 11 Twp. 19 S, Rg. 21 X East
3960 Ft. from South Line of Section
1320 Ft. from East Line of Section

(Note: Locate well on Section Plat on reverse side)

CONTRACTOR: License # 03518
Name Eastern Kansas Drilling, Inc.
City/State Stanley, Kansas 66221

Nearest lease or unit boundary line 1320 feet
County Miami

Lease Name Hay Well # 1
Ground surface elevation NA feet MSL

Well Drilled For: Well Class: Type Equipment:
X Oil — Storage — Infield — Mud Rotary
— Gas — Inj — Pool Ext. X Air Rotary
— OWWO — Expl X Wildcat — Cable

Domestic well within 330 feet: — yes X no
Municipal well within one mile: — yes X no

Depth to bottom of fresh water None
Depth to bottom of usable water 200'
Surface pipe by Alternate: 1 2 X

If OWWO: old well info as follows:

Surface pipe planned to be set 20'
Conductor pipe required None
Projected Total Depth 1000' feet
Formation Mississippi

Operator
Well Name
Comp Date Old Total Depth

I certify that well will comply with K.S.A. 55-101, et seq., plus eventually plugging hole to KCC specifications.

Date 8/29/87 Signature of Operator or Agent Roger B. Stover Title Pres.

For KCC Use:


Conductor Pipe Required feet; Minimum Surface Pipe Required feet per Alt. XO 2
This Authorization Expires 2-26-88 Approved By 8-26-87

Must be filed with the K.C.C. five (5) days prior to commencing well
This card void if drilling not started within six (6) months of date received by K.C.C.

Important procedures to follow:

1. Notify District office before setting surface casing.
2. Set surface casing by circulating cement to the top.
3. File completion forms ACO-1 with K.C.C. within 120 days of well spud date, following instructions on ACO-1, side 1, and including copies of wireline logs.
4. Notify District office 48 hours prior to old well workover or re-entry.
5. Prior to filing Intent, prepare a proposed plugging plan in case well is D & A, then obtain approval of plan when calling district office prior to setting surface pipe.
6. Submit plugging report (CP-4) to K.C.C. after plugging is completed.
7. Obtain an approved injection docket number before disposing of salt water.
8. Notify K.C.C. within 10 days when injection commences or terminates.
9. If an alternate 2 completion, cement in the production pipe from below any usable water to surface within 120 days of spud date.

A Regular Section of Land 1 Mile = 5,280 Ft.

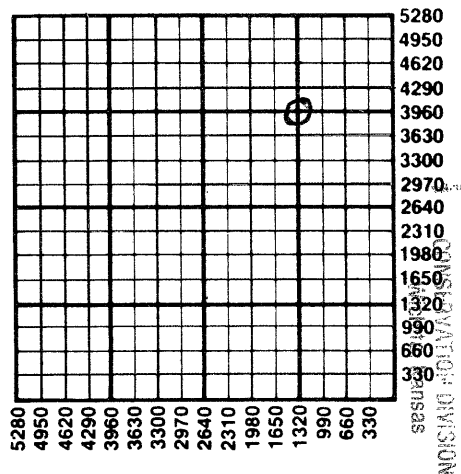

STATE CORPORATION COMMISSION

AUG 26 1987

State Corporation Commission of Kansas
Conservation Division
200 Colorado Derby Building
Wichita, Kansas 67202-1212
(316) 263-3238