

CARD MUST BE TYPED

State of Kansas

CARD MUST BE SIGNED

### NOTICE OF INTENTION TO DRILL

(see rules on reverse side)

b Starting Date April 30, 1986  
month day year

API Number 15— 207-25472-0000

OPERATOR: License # 7619  
Name Fred Gee  
Address Box 602  
City/State/Zip A. Eureka, Kansas  
Contact Person Fred Gee  
Phone 316-583-5368

East  
SE. NW. NE. Sec 24.... Twp. 24. S, Rg. 15. \_\_\_ West  
4220  
1370  
..... Ft. from South Line of Section  
..... Ft. from East Line of Section

(Note: Locate well on Section Plat on reverse side)

Nearest lease or unit boundary line 50..... feet  
County Woodson

CONTRACTOR: License # 5367  
Name Double I. Drilling  
City/State Yates Center, Kansas

Lease Name Cool..... Well # INJ - 2  
Ground surface elevation Unknown..... feet MSL

Well For: Well Class: Type Equipment:  
 Oil \_\_\_ SWD  Infield \_\_\_  Mud Rotary  
\_\_\_ Gas  Inj \_\_\_ Pool Ext. \_\_\_ Air Rotary  
\_\_\_ OWWO \_\_\_ Expl \_\_\_ Wildcat \_\_\_ Cable

Domestic well within 330 feet: \_\_\_yes  no  
Municipal well within one mile: \_\_\_yes  no

If OWWO: old well info as follows:  
Operator .....,  
Well Name .....,  
Comp Date ....., Old Total Depth.....

Depth to bottom of fresh water 20.....  
Depth to bottom of usable water 250-150.....  
Surface pipe by Alternate: 1 \_\_\_ 2   
Surface pipe planned to be set 40.....  
Conductor pipe required None.....  
Projected Total Depth 1175..... feet  
Formation Squirrel.....

I certify that well will comply with K.S.A. 55-101, et seq., plus eventually plugging hole to KCC specifications.  
Date 4/28/86 Signature of Operator or Agent [Signature] Title Partner

For KCC Use:  
Conductor Pipe Required ..... feet; Minimum Surface Pipe Required ..... feet per Alt. 40  
This Authorization Expires 10-25-86 Approved By [Signature] 4-25-86


[Signature]

Must be filed with the K.C.C. five (5) days prior to commencing well  
This card void if drilling not started within six (6) months of date received by K.C.C.

### Important procedures to follow:

1. Notify District office before setting surface casing.
2. Set surface casing by circulating cement to the top.
3. File completion forms ACO-1 with K.C.C. within 90 days of well completion, following instructions on ACO-1, side 1, and including copies of wireline logs.
4. Notify District office 48 hours prior to old well workover or re-entry.
5. Prior to filing Intent, prepare a proposed plugging plan in case well is D & A, then obtain approval of plan when calling district office prior to setting surface pipe.
6. Submit plugging report (CP-4) to K.C.C. after plugging is completed.
7. Obtain an approved injection docket number before disposing of salt water.
8. Notify K.C.C. within 10 days when injection commences or terminates.
9. If an alternate 2 completion, cement in the production pipe from below any usable water to surface within 120 days of spud date.

### A Regular Section of Land 1 Mile = 5,280 Ft.

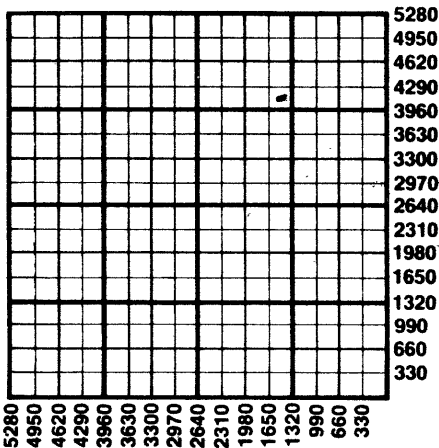

**RECEIVED**  
STATE CORPORATION COMMISSION

425-86

APR 25 1986

CONSERVATION DIVISION

State Corporation Commission of Kansas  
Conservation Division  
200 Colorado Derby Building  
Wichita, Kansas 67202  
(316) 263-3238