

CARD MUST BE TYPED

State of Kansas

CARD MUST BE SIGNED

NOTICE OF INTENTION TO DRILL

(see rules on reverse side)

Starting Date March 3, 1987
month day year 11:49

API Number 15- 121-26792-00-00
 East

OPERATOR: License # 6211
Name William H. Macauluske
Address 127 W. 10th #430
City/State/Zip Kansas City MO 64105
Contact Person Tom Moylan
Phone 913-757-4426

SW NE SE. Sec...9... Twp...19. S, Rg...24... ~~West~~
1790 Ft. from South Line of Section
900 Ft. from East Line of Section

(Note: Locate well on Section Plat on reverse side)

CONTRACTOR: License # 5872
Name Thomas & Moylan
City/State LaCygne KS 66040

Nearest lease or unit boundary line 900 feet
County Miami

Well Drilled For: Well Class: Type Equipment:
 Oil SWD Infield Mud Rotary
 Gas Inj Pool Ext. Air Rotary
 OWWO Expl Wildcat Cable

Lease Name Peacock Well # 1-87
Ground surface elevation 923 feet MSL

If OWWO: old well info as follows:
Operator
Well Name
Comp Date Old Total Depth

Domestic well within 330 feet: yes no
Municipal well within one mile: yes no
Depth to bottom of fresh water 220
Depth to bottom of usable water 200
Surface pipe by Alternate: 1 2
Surface pipe planned to be set 20
Conductor pipe required
Projected Total Depth 250 feet
Formation PERU

I certify that well will comply with K.S.A. 55-101, et seq., plus eventually plugging hole to KCC specifications.
Date 3/2/87 Signature of Operator or Agent William H. Macauluske Title As Agent

For KCC Use:
Conductor Pipe Required feet; Minimum Surface Pipe Required 20 feet per Alt. 20
This Authorization Expires 9-2-87 Approved By S-R-A-T


[Handwritten signature]

Must be filed with the K.C.C. five (5) days prior to commencing well
This card void if drilling not started within six (6) months of date received by K.C.C.

Important procedures to follow:

**A Regular Section of Land
1 Mile = 5,280 Ft.**

1. Notify District office before setting surface casing.
2. Set surface casing by circulating cement to the top.
3. File completion forms ACO-1 with K.C.C. within 120 days of well spud date, following instructions on ACO-1, side 1, and including copies of wireline logs.
4. Notify District office 48 hours prior to old well workover or re-entry.
5. Submit plugging report (CP-4) to K.C.C. after plugging is completed.
6. If an alternate 2 completion, cement in the production pipe from below any usable water to surface within 120 days of spud date.

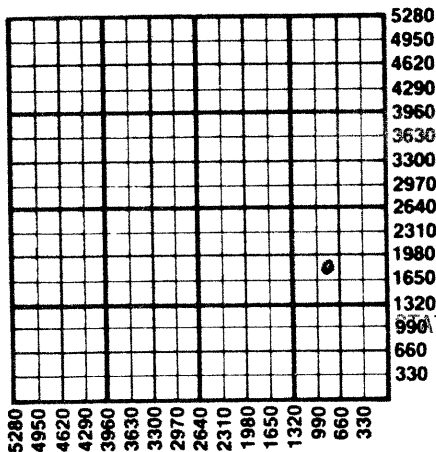

RECEIVED
STATE CORPORATION COMMISSION

MAR 2 - 1987

CONSERVATION DIVISION
Wichita, Kansas

State Corporation Commission of Kansas
Conservation Division
200 Colorado Derby Building
Wichita, Kansas 67202-1212
(316) 263-3238