

CARD MUST BE TYPED

State of Kansas

CARD MUST BE SIGNED

NOTICE OF INTENTION TO DRILL

(see rules on reverse side)

Expected Spud Date..... **MARCH 31, 1987**
month day year **12:00**

API Number 15— **121-26,794-00-00** East

OPERATOR: License # **#6211**
Name **WILLIAM H. MCCLUSKEY**

NE. NE. SE Sec. **9** Twp. **19** S, Rg. **24** — West

Address **127 W. 10TH. SO. #430**

2500 Ft. from South Line of Section

City/State/Zip **KANSAS CITY, MO 64105**

550 Ft. from East Line of Section

Contact Person **TOM MOYLAN**

(Note: Locate well on Section Plat on reverse side)

Phone **913-757-4426**

Nearest lease or unit boundary line **550** feet

CONTRACTOR: License # **#5872**
Name **THOMAS MOYLAN**

County **MIAMI**

City/State **P. O. BOX 150, IOWA, KS 66749**

Lease Name **PEACOCK E.** Well # **PE8-87**

Well Drilled For: Oil Storage Infield Mud Rotary

Ground surface elevation **1080** feet MSL

Gas Inj Pool Ext. Air Rotary

Domestic well within 330 feet: yes no

OWWO Expl Wildcat Cable

Municipal well within one mile: yes no

If OWWO: old well info as follows:

Operator
Well Name
Comp Date Old Total Depth

Depth to bottom of fresh water

Depth to bottom of usable water **100**

Surface pipe by Alternate: **20 OF 6 1/4" ²**

Surface pipe planned to be set

Conductor pipe required **250**

Projected Total Depth **PERU** feet

I certify that well will comply with K.S.A. 55-101, et seq., plus eventually plugging hole to KCC specifications

Date **3/31/87** Signature of Operator or Agent **Greg Engleman**

Formation

For KCC Use:

Conductor Pipe Required feet; Minimum Surface Pipe Required

Title **AS AGENT**

This Authorization Expires **10-1-87**


Approved By **3-31-87** feet per Alt. **20**

Must be filed with the K.C.C. five (5) days prior to commencing well
 This card void if drilling not started within six (6) months of date received by K.C.C.

Important procedures to follow:

1. Notify District office before setting surface casing.
2. Set surface casing by circulating cement to the top.
3. File completion forms ACO-1 with K.C.C. within 120 days of well spud date, following instructions on ACO-1, side 1, and including copies of wireline logs.
4. Notify District office 48 hours prior to old well workover or re-entry.
5. Prior to filing Intent, prepare a proposed plugging plan in case well is D & A, then obtain approval of plan when calling district office prior to setting surface pipe.
6. Submit plugging report (CP-4) to K.C.C. after plugging is completed.
7. Obtain an approved injection docket number before disposing of salt water.
8. Notify K.C.C. within 10 days when injection commences or terminates.
9. If an alternate 2 completion, cement in the production pipe from below any usable water to surface within 120 days of spud date.

A Regular Section of Land
1 Mile = 5,280 Ft.

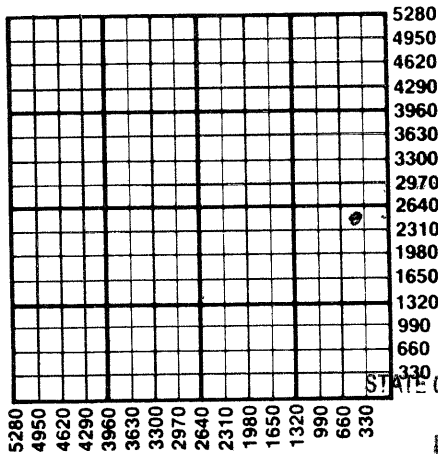

RECEIVED
 STATE CORPORATION COMMISSION

MAR 31 1987

CONSERVATION Division
 Wichita, Kansas

State Corporation Commission of Kansas
 Conservation Division
 200 Colorado Derby Building
 Wichita, Kansas 67202-1212
 (316) 263-3238