

CARD MUST BE TYPED

State of Kansas

CARD MUST BE SIGNED

NOTICE OF INTENTION TO DRILL

(see rules on reverse side)

Expected Spud Date..... 5-27-1987
month day year

API Number 15— 121-26,819.00-00 ^{DRY}

OPERATOR: License # 6211
Name William McCluskey
Address 127 West 10th Street, Suite 430
City/State/Zip Kansas City, MO 64105
Contact Person Thomas F. Moylan
Phone (913) 757-4426

SE NW NE
4540 Sec. 9 Twp. 19 S, Rg. 24 East
1764 West
Ft. from South Line of Section
Ft. from East Line of Section

(Note: Locate well on Section Plat on reverse side)

CONTRACTOR: License # 5872
Name Thomas F. Moylan
City/State Route 2, LaCygne, Kansas 66040

Nearest lease or unit boundary line 165 feet
County Miami

Lease Name Peacock Well # N2-87
Ground surface elevation feet MSL

Well Drilled For: Well Class: Type Equipment:
 Oil Storage Infield Mud Rotary
 Gas Inj Pool Ext. Air Rotary
 OWWO Expl Wildcat Cable

Domestic well within 330 feet: yes no
Municipal well within one mile: yes no

If OWWO: old well info as follows:

Depth to bottom of fresh water:

Depth to bottom of usable water 150-200
Surface pipe by Alternate: 1 2

Surface pipe planned to be set 20
Conductor pipe required

Projected Total Depth 200 feet
Formation

I certify that well will comply with K.S.A. 55-101, et seq., plus eventually plugging hole to KCC specifications.

Date 5/26/87 Signature of Operator or Agent Greg Engleman Title AS AGENT

For KCC Use:

Conductor Pipe Required .. feet; Minimum Surface Pipe Required 20 feet per Alt. ²

This Authorization Expires 11-26-87 Approved By 5-26-87


Handwritten signature/initials

Must be filed with the K.C.C. five (5) days prior to commencing well
This card void if drilling not started within six (6) months of date received by K.C.C.

Important procedures to follow:

1. Notify District office before setting surface casing.
2. Set surface casing by circulating cement to the top.
3. File completion forms ACO-1 with K.C.C. within 120 days of well spud date, following instructions on ACO-1, side 1, and including copies of wireline logs.
4. Notify District office 48 hours prior to old well workover or re-entry.
5. Prior to filing Intent, prepare a proposed plugging plan in case well is D & A, then obtain approval of plan when calling district office prior to setting surface pipe.
6. Submit plugging report (CP-4) to K.C.C. after plugging is completed.
7. Obtain an approved injection docket number before disposing of salt water.
8. Notify K.C.C. within 10 days when injection commences or terminates.
9. If an alternate 2 completion, cement in the production pipe from below any usable water to surface within 120 days of spud date.

A Regular Section of Land 1 Mile = 5,280 Ft.

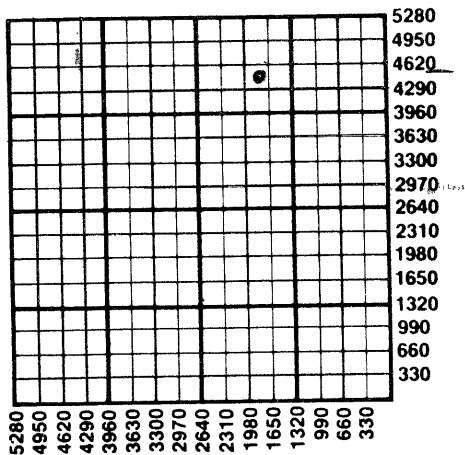

State Corporation Commission of Kansas
Conservation Division
200 Colorado Derby Building
Wichita, Kansas 67202-1212
(316) 263-3238