

CARD MUST BE TYPED

State of Kansas NOTICE OF INTENTION TO DRILL

(see rules on reverse side)

CARD MUST BE SIGNED

Starting Date: 5 13 85
month day year

API Number 15- 207-25, 268-00-00

OPERATOR: License # 8864

Name Mike O'Connor

Address P.O. BOX 487

City/State/Zip Marble Falls, TX 78654

Contact Person John E. Leis

Phone 316-625-3601

CONTRACTOR: License # 5367

Name Double L Drilling Co.

City/State Yates Center, KS 66783

Well Drilled For: Well Class: Type Equipment:

☒ Oil ☐ Swd ☒ Infield ☒ Mud Rotary

☐ Gas ☐ Inj ☐ Pool Ext. ☐ Air Rotary

☐ OWWO ☐ Expl ☐ Wildcat ☐ Cable

If OWWO: old well info as follows:

Operator

Well Name

Comp Date Old Total Depth

Projected Total Depth 1100 feet

Projected Formation at TD Squirrel

Expected Producing Formations Squirrel

I certify that we will comply with K.S.A. 55-101, et seq., plus eventually plugging hole to K.C.C. specifications.

Date 5-8-85 Signature of Operator or Agent Carol Anne Roush

NE SW SE Sec 16 Twp 24 S Rge 16 ☒ East
(location) ☐ West

1155 Ft North from Southeast Corner of Section

1485 Ft West from Southeast Corner of Section

(Note: Locate well on Section Plat on reverse side)

Nearest lease or unit boundary line 165 feet.

County Woodson

Lease Name Jones Well # 5

Domestic well within 330 feet: ☐ yes ☒ no

Municipal well within one mile: ☐ yes ☒ no

Depth to Bottom of fresh water 18 feet

Lowest usable water formation sandstone

Depth to Bottom of usable water 150 feet

Surface pipe by Alternate: 1 ☐ 2 ☒

Surface pipe to be set 40 feet

Conductor pipe if any required none feet

Ground surface elevation unknown feet MSL

This Authorization Expires 11-9-85


Approved By 5-9-85 RC

KCDP-KDHE
5-9-85

Must be filed with the K.C.C. five (5) days prior to commencing well
This card void if drilling not started within six (6) months of date received by K.C.C.

Important procedures to follow :

**A Regular Section of Land
1 Mile = 5,280 Ft.**

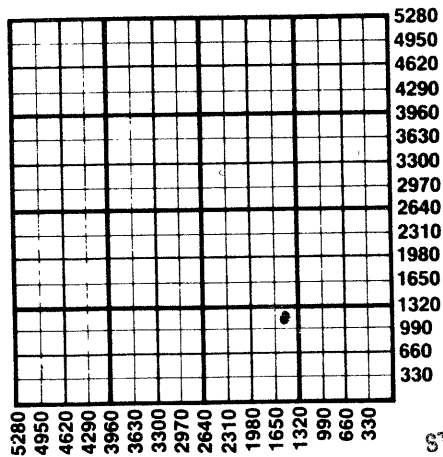

1. Notify District office before setting surface casing.
2. Set surface casing by circulating cement to the top.
3. File completion forms ACO-1 with K.C.C. within 90 days of well completion, following instructions on ACO-1, side 1, and including copies of wireline logs.
4. Notify District office 48 hours prior to old well workover or re-entry.
5. Prior to plugging, prepare a plugging plan, then obtain agreement from the appropriate district office for an approved plugging plan.
6. Submit plugging report (CP-4) to K.C.C. after plugging is completed.
7. Obtain an approved injection docket number before disposing of salt water.
8. Notify K.C.C. within 10 days when injection commences or terminates.
9. If an alternate 2 completion, cement in the production pipe from below any available water to surface within 120 days of spud date.

RECEIVED
STATE CORPORATION COMMISSION

State Corporation Commission of Kansas
Conservation Division
200 Colorado Derby Building
Wichita, Kansas 67202
(316) 263-3238

59-85 MAY 09 1985
CONSERVATION DIVISION
Wichita, Kansas