

CARD MUST BE TYPED

State of Kansas  
**NOTICE OF INTENTION TO DRILL**  
 (see rules on reverse side)

CARD MUST BE SIGNED

Starting Date: April 10 ; 1986  
 month day year

OPERATOR: License # 5367  
 Name Double L. Drilling  
 Address P.O. Box 284  
 City/State/Zip Yates Center, KS 66783  
 Contact Person John Leis

Phone 316.625.2485  
 CONTRACTOR: License # 5367  
 Name Double L. Drilling  
 City/State Yates Center, K.S. 66783

Well Drilled For:	Well Class:	Type Equipment:
<input checked="" type="checkbox"/> Oil	<input checked="" type="checkbox"/> Infield	<input checked="" type="checkbox"/> Mud Rotary
<input type="checkbox"/> Gas	<input type="checkbox"/> Pool Ext.	<input type="checkbox"/> Air Rotary
<input type="checkbox"/> OWWO	<input type="checkbox"/> Wildcat	<input type="checkbox"/> Cable

If OWWO: old well info as follows:

Operator  
 Well Name  
 Comp Date Old Total Depth  
 Projected Total Depth 1040 feet  
 Projected Formation at TD 1060  
 Expected Producing Formations Sevier sand

I certify that we will comply with K.S.A. 55-101, et seq., plus eventually plugging hole to K.C.C. specifications.

API Number 15- 207-25,467-00-00

NE... SW... SE Sec 16 Twp 24 S, Rge 16... ☒ East  
 (location) ☐ West

1155 Ft North from Southeast Corner of Section  
 1485 Ft West from Southeast Corner of Section  
 (Note: Locate well on Section Plat on reverse side)

Nearest lease or unit boundary line 165 feet.

County Woodson

Lease Name Jones Well# 4

Domestic well within 330 feet: ☐ yes ☒ noMunicipal well within one mile: ☐ yes ☒ no

Depth to Bottom of fresh water 20 feet

Lowest usable water formation Sandstone

Depth to Bottom of usable water 250.150 feet

Surface pipe by Alternate: 1 ☐ 2 ☒

Surface pipe to be set 40 feet

Conductor pipe if any required None feet

Ground surface elevation unknown feet MSL

This Authorization Expires 10-2-86


Approved By 4-7-86

Date April 1, 1986 Signature of Operator or Agent

Title

**Important procedures to follow :**

**1 Mile = 5,280 Ft.**

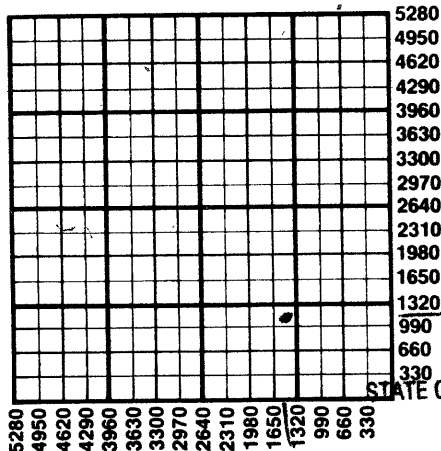

RECEIVED

330 STATE CORPORATION COMMISSION

APR 1 1986

CONSERVATION DIVISION  
Wichita, Kansas

4-1-76

1. Notify District office before setting surface casing.
  2. Set surface casing by circulating cement to the top.
  3. File completion forms ACO-1 with K.C.C. within 90 days of well completion, following instructions on ACO-1, side 1, and including copies of wireline logs.
  4. Notify District office 48 hours prior to old well workover or re-entry.
  5. Prior to plugging, prepare a plugging plan, then obtain agreement from the appropriate district office for an approved plugging plan.
  6. Submit plugging report (CP-4) to K.C.C. after plugging is completed.
  7. Obtain an approved injection docket number before disposing of salt water.
  8. Notify K.C.C. within 10 days when injection commences or terminates.
- VED an alternate 2 completion, cement in the production pipe from below  
now commission water to surface within 120 days of spud date.

**State Corporation Commission of Kansas  
Conservation Division  
200 Colorado Derby Building  
Wichita, Kansas 67202  
(316) 263-3238**