

CARD MUST BE TYPED

State of Kansas NOTICE OF INTENTION TO DRILL

(see rules on reverse side)

CARD MUST BE SIGNED

Starting Date: June 8 1985
month day year

API Number 15- 207-25305-00-00
 East

OPERATOR: License # 7937
Name Timoco
Address Box 190
City/State/Zip Snowmass, Co. 81654
Contact Person A.E. Allison
Phone 625-2040

Plat C/N $\frac{1}{2}$ SE NE $\frac{1}{4}$ Sec 27. Twp 25. S, Rge 15. West
(location)

36.30 Ft North from Southeast Corner of Section
600 Ft West from Southeast Corner of Section
(Note: Locate well on Section Plat on reverse side)

CONTRACTOR: License # 5367
Name Double "L" Drilling
City/State Yates Center, Kansas

Nearest lease or unit boundary line 600 feet.
County Woodson
Lease Name Thelma Ropp Well# 4

Well Drilled For: Well Class: Type Equipment:
 Oil Swd Infield Mud Rotary
 Gas Inj Pool Ext. Air Rotary
 OWWO Expl Wildcat Cable

Domestic well within 330 feet: yes no
Municipal well within one mile: yes no

If OWWO: old well info as follows:

Operator N/A
Well Name N/A
Comp Date N/A Old Total Depth N/A
Projected Total Depth 1175 feet
Projected Formation at TD Squirrel Sandstone
Expected Producing Formations Squirrel Sandstone

Depth to Bottom of fresh water 25 95 *2 H₂O* feet
Lowest usable water formation Sandstone
Depth to Bottom of usable water 40 150 feet
Surface pipe by Alternate: 1 2
Surface pipe to be set 40 feet
Conductor pipe if any required None feet
Ground surface elevation 1093 feet MSL
This Authorization Expires 12-3-85
Approved By 6-3-85 *R*

I certify that we will comply with K.S.A. 55-101, et seq., plus eventually plugging hole to K.C.C. specifications.

Date May 30, 1985 Signature of Operator or Agent *Carol...*


Title Partner

2 H₂O / KOHE 6-3-85 Form C-1 4/84

**Must be filed with the K.C.C. five (5) days prior to commencing well
This card void if drilling not started within six (6) months of date received by K.C.C.**

Important procedures to follow :

**A Regular Section of Land
1 Mile = 5,280 Ft.**

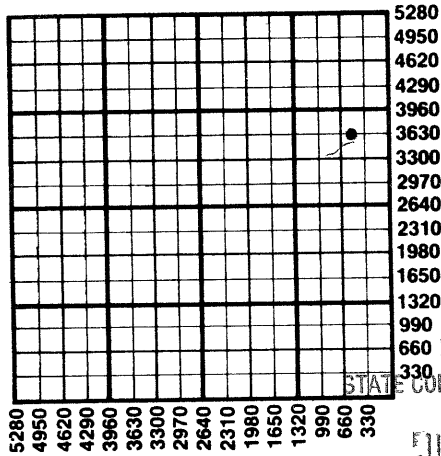

1. Notify District office before setting surface casing.
 2. Set surface casing by circulating cement to the top.
 3. File completion forms ACO-1 with K.C.C. within 90 days of well completion, following instructions on ACO-1, side 1, and including copies of wireline logs.
 4. Notify District office 48 hours prior to old well workover or re-entry.
 5. Prior to plugging, prepare a plugging plan, then obtain agreement from the appropriate district office for an approved plugging plan.
 6. Submit plugging report (CP-4) to K.C.C. after plugging is completed.
 7. Obtain an approved injection docket number before disposing of salt water.
 8. Notify K.C.C. within 10 days when injection commences or terminates.
- If an alternate 2 completion, cement in the production pipe from below any usable water to surface within 120 days of spud date.

RECEIVED
STATE CORPORATION COMMISSION

JUN 03 1985

CONSERVATION DIVISION
Wichita, Kansas
63-85

**State Corporation Commission of Kansas
Conservation Division
200 Colorado Derby Building
Wichita, Kansas 67202
(316) 263-3238**