

CARD MUST BE TYPED

State of Kansas

CARD MUST BE SIGNED

NOTICE OF INTENTION TO DRILL

(see rules on reverse side)

Expected Spud Date. Oct. 12 1987
 month day year

OPERATOR: License # 7937
 Name Timoco
 Address Box 95
 City/State/Zip Chanute, Kansas 66720
 Contact Person Alfred E. Allison
 Phone 316-625-2040

CONTRACTOR: License # 6430 9430
 Name CMT Petro Resources Inc.
 City/State Yates Center, Kansas

Well Drilled For: Well Class: Type Equipment:
☒ Oil ☐ Storage ☒ Infield ☒ Mud Rotary
☐ Gas ☐ Inj ☐ Pool Ext. ☐ Air Rotary
☐ OWWO ☐ Expl ☐ Wildcat ☐ Cable

If OWWO: old well info as follows:

Operator NA
 Well Name NA
 Comp Date NA Old Total Depth NA

I certify that well will comply with K.S.A. 55-101, et seq., plus eventually plugging hole to KCC specifications.

Date 10-5-87 Signature of Operator or Agent [Signature] Title Partner

For KCC Use:

Conductor Pipe Required feet; Minimum Surface Pipe Required 40 feet per Alt. 1 2
 This Authorization Expires 4-9-88 Approved By [Signature] 10-9-87

EFFECTIVE DATE 10-14-87

API Number 15— 207-25536-0000

NE. SE. SE. Sec. 27 Twp. 25 S, Rg. 15 ☒ East
700 ☐ West
310 Ft. from South Line of Section
 Ft. from East Line of Section

(Note: Locate well on Section Plat on reverse side)

Nearest lease or unit boundary line 310 feet
 County Woodson

Lease Name Alfred E. Allison Well # 5
 Ground surface elevation 1070 feet MSL

Domestic well within 330 feet: ☐ yes ☒ noMunicipal well within one mile: ☐ yes ☒ noDepth to bottom of fresh water 25 feet 100Depth to bottom of usable water 150 feetSurface pipe by Alternate: 1 2 ☒Surface pipe planned to be set 40 feet of 7"Conductor pipe required noneProjected Total Depth 1165 feetFormation Squirrel ss.


Must be filed with the K.C.C. five (5) days prior to commencing well
This card void if drilling not started within six (6) months of date received by K.C.C.

Important procedures to follow:

1. Notify District office before setting surface casing.
 2. Set surface casing by circulating cement to the top.
 3. File completion forms ACO-1 with K.C.C. within 120 days of well spud date, following instructions on ACO-1, side 1, and including copies of wireline logs.
 4. Notify District office 48 hours prior to old well workover or re-entry.
 5. Prior to filing Intent, prepare a proposed plugging plan in case well is D & A, then obtain approval of plan when calling district office prior to setting surface pipe.
 6. Submit plugging report (CP-4) to K.C.C. after plugging is completed.
 7. Obtain an approved injection docket number before disposing of salt water.
 8. Notify K.C.C. within 10 days when injection commences or terminates.
- If an alternate 2 completion, cement in the production pipe from below any usable water to surface within 120 days of spud date.

State Corporation Commission of Kansas
Conservation Division
200 Colorado Derby Building
Wichita, Kansas 67202-1212
(316) 263-3238

A Regular Section of Land
1 Mile = 5,280 Ft.

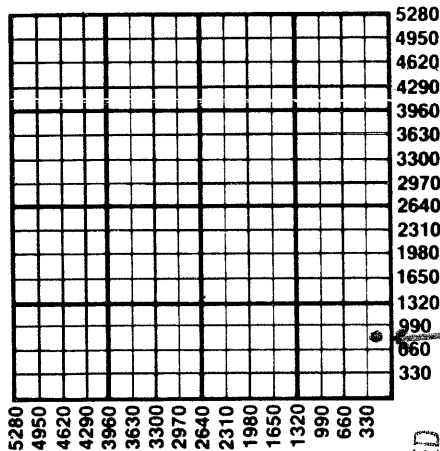

RECEIVED
STATE CORPORATION COMMISSION

OCT 9 1987

CONSERVATION DIVISION
Wichita, Kansas

10-9-87