

CARD MUST BE TYPED

State of Kansas

CARD MUST BE SIGNED

# NOTICE OF INTENTION TO DRILL

(see rules on reverse side)

\*\* CORRECTED CARD

Expected Spud Date..... 6 month 15 day 1988 year

API Number 15- 15-207-25,555 *00007*

OPERATOR: License #..... 7937  
Name ..... TIMOCO  
Address ..... Box 190  
City/State/Zip ..... Snowmass, Colo. 81654  
Contact Person..... Ron A. Timroth  
Phone ..... (303) 927-3729

\*\* SE SE SE Sec. 27 Twp. 25 S, Rg. 15 X East  
\*\* ..... 165 ..... Ft. from South Line of Section  
\*\* ..... 341 ..... Ft. from East Line of Section

(Note: Locate well on Section Plat on reverse side)

\*\* Nearest lease or unit boundary line ..... 165 ..... feet  
County..... WOODSON

CONTRACTOR: License #..... 5378  
Name ..... Fleming Drilling Co.  
City/State..... Chanute, Kansas... 66702

Lease Name..... A. E. ALLISON Well #..... 6  
Ground surface elevation ..... 1107 ..... feet MSL

Well Drilled For: Well Class: Type Equipment:  
 Oil  Storage  Infield  Mud Rotary  
 Gas  Inj  Pool Ext.  Air Rotary  
 OWWO  Expl  Wildcat  Cable

Domestic well within 330 feet:  yes  no  
Municipal well within one mile:  yes  no

IF OWWO: old well info as follows:

Operator .....  
Well Name .....  
Comp Date ..... Old Total Depth.....

Depth to bottom of fresh water..... 25 .....  
Depth to bottom of usable water ..... 150 .....  
Surface pipe by Alternate: 1  2

I certify that well will comply with K.S.A. 55-101, et seq., plus eventually plugging hole to KCC specifications.

Date ... 6-15-88 ..... Signature of Operator or Agent *Frank Dredger* Title..... Agent.....

For KCC Use:

Conductor Pipe Required ..... feet; Minimum Surface Pipe Required ..... 40 feet per Alt. *2*

This Authorization Expires *12-9-88* ..... Approved By *PCH 6-9-88* .....  
\*\* WAS: NW - 734 FSL & 1113 FEL-734 NLL


TD-1460 MISS LM

Must be filed with the K.C.C. five (5) days prior to commencing well  
 This card void if drilling not started within six (6) months of date received by K.C.C.

**Important procedures to follow:**

1. Notify District office before setting surface casing.
  2. Set surface casing by circulating cement to the top.
  3. File completion forms ACO-1 with K.C.C. within 120 days of well spud date, following instructions on ACO-1, side 1, and including copies of wireline logs.
  4. Notify District office 48 hours prior to old well workover or re-entry.
  5. Prior to filing Intent, prepare a proposed plugging plan in case well is D & A, then obtain approval of plan when calling district office prior to setting surface pipe.
  6. Submit plugging report (CP-4) to K.C.C. after plugging is completed.
  7. Obtain an approved injection docket number before disposing of salt water.
8. Notify K.C.C. within 10 days when injection commences or terminates.
9. If an alternate 2 completion, cement in the production pipe from below any usable water to surface within 120 days of spud date.

**A Regular Section of Land  
 1 Mile = 5,280 Ft.**

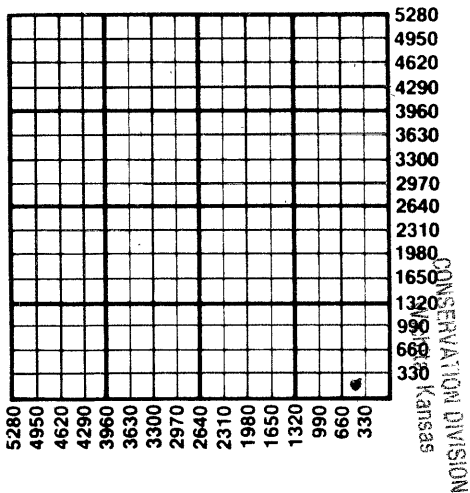

**JUN 15 1988**

STATE CORPORATION COMMISSION  
 CONSERVATION DIVISION

6-15-88

State Corporation Commission of Kansas  
 Conservation Division  
 200 Colorado Derby Building  
 Wichita, Kansas 67202-1212  
 (316) 263-3238