

CARD MUST BE TYPED

State of Kansas

CARD MUST BE SIGNED

NOTICE OF INTENTION TO DRILL

(see rules on reverse side)

Starting Date 1 30 1986
month day year

9:45

API Number 15-003-22,732-00-00

OPERATOR: License # 7093
Name Milo Gadelman
Address Rt. 1
City/State/Zip Garnett, Kansas 66032
Contact Person Milo Gadelman
Phone (316) 365-3981

app. SW SE SE Sec. 6 Twp. 21 S, Rg. 21
_____ East
_____ West
600 Ft. from South Line of Section
1125 Ft. from East Line of Section

(Note: Locate well on Section Plat on reverse side)

CONTRACTOR: License # 5820
Name Kent Drilling Co.
City/State 332 W. 8th, Garnett, KS 66032

Nearest lease or unit boundary line 600 feet
County Anderson
Lease Name Milo Gadelman Well # 9
Ground surface elevation na feet MSL

Well Drilled For: Well Class: Type Equipment:
 Oil SWD Infield Mud Rotary
 Gas Inj Pool Ext. Air Rotary
 OWWO Expl Wildcat Cable

Domestic well within 330 feet: _____ yes no
Municipal well within one mile: _____ yes no
Depth to bottom of fresh water none 20
Depth to bottom of usable water 100
Surface pipe by Alternate: 1 _____ 2 _____
Surface pipe planned to be set 20
Conductor pipe required
Projected Total Depth 700 feet
Formation Squirrel


If OWWO: old well info as follows:
Operator
Well Name
Comp Date Old Total Depth

I certify that well will comply with K.S.A. 55-101, et seq., plus eventually plugging hole to KCC specifications.
Date 1/30/86 Signature of Operator or Agent *Kevin Cholan* as agent *Permittee* Title _____

For KCC Use:
Conductor Pipe Required _____ feet; Minimum Surface Pipe Required _____ feet per Alt. *20* *X*
This Authorization Expires *7-30-86* Approved By *1-30-86* *R*

Must be filed with the K.C.C. five (5) days prior to commencing well
This card void if drilling not started within six (6) months of date received by K.C.C.

A Regular Section of Land
1 Mile = 5,280 Ft.

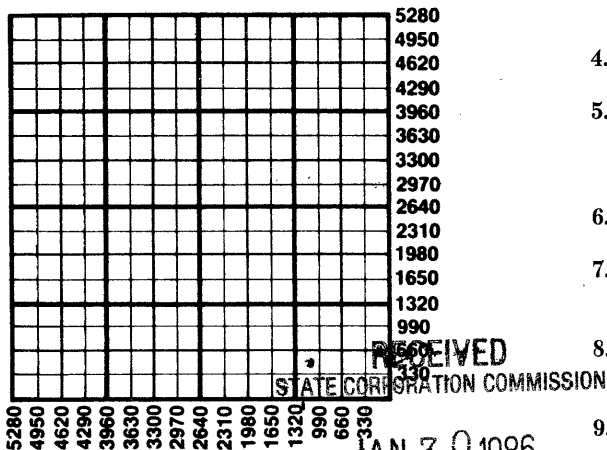

Important procedures to follow:

1. Notify District office before setting surface casing.
2. Set surface casing by circulating cement to the top.
3. File completion forms ACO-1 with K.C.C. within 90 days of well completion, following instructions on ACO-1, side 1, and including copies of wireline logs.
4. Notify District office 48 hours prior to old well workover or re-entry.
5. Prior to filing Intent, prepare a proposed plugging plan in case well is D & A, then obtain approval of plan when calling district office prior to setting surface pipe.
6. Submit plugging report (CP-4) to K.C.C. after plugging is completed.
7. Obtain an approved injection docket number before disposing of salt water.
8. Notify K.C.C. within 10 days when injection commences or terminates.
9. If an alternate 2 completion, cement in the production pipe from below any usable water to surface within 120 days of spud date.

State Corporation Commission of Kansas
Conservation Division
200 Colorado Derby Building
Wichita, Kansas 67202
(316) 263-3238