

CARD MUST BE TYPED

State of Kansas

CARD MUST BE SIGNED

NOTICE OF INTENTION TO DRILL

(see rules on reverse side)

Starting Date October 23, 1985
month day year

API Number 15— 001-27,608-0000

OPERATOR: License # 7046
Name Wilson Pulling & Production
Address 401 S. Buckeye
City/State/Zip Iola, KS 66749
Contact Person Herb Wilson
Phone 316 365 2129E/2. W/2. E/2. Sec. 36. Twp. 24. S. Rg. 17. ☒ East
..... 2640 Ft. from South Line of Section
..... 1485 Ft. from East Line of Section

(Note: Locate well on Section Plat on reverse side)

CONTRACTOR: License # 5661
Name Kelly Down Drilling Company
City/State R. 1, Box 84, Neosho Falls, Ks 66758Nearest lease or unit boundary line 165 feet
County Allen

Lease Name Homer L. Teats Well # 1A

Ground surface elevation feet MSL

Well Drilled For: Well Class: Type Equipment:
☒ Oil ☐ SWD ☒ Infield ☒ Mud Rotary
☐ Gas ☐ Inj ☐ Pool Ext. ☐ Air Rotary
☐ OWWO ☐ Expl ☐ Wildcat ☐ CableDomestic well within 330 feet: ☐ yes ☒ noMunicipal well within one mile: ☐ yes ☒ noSurface pipe by Alternate: 1 ☒ 2 ☒

Depth to bottom of fresh water 30' none

Depth to bottom of usable water 150

Surface pipe planned to be set 20

Projected Total Depth 875 feet

Formation Squirrel

If OWWO: old well info as follows:

Operator
Well Name
Comp Date Old Total Depth

I certify that well will comply with K.S.A. 55-101, et seq., plus eventually plugging hole to KCC specifications.

cementing will be done immediately upon setting production casing.

Date 10/23/85 Signature of Operator or Agent Title as agent

For KCC Use:

Conductor Pipe Required feet; Minimum Surface Pipe Required feet per Alt. 1 2

This Authorization Expires 1-23-86 Approved By 10-23-85

Must be filed with the K.C.C. five (5) days prior to commencing well
This card void if drilling not started within six (6) months of date received by K.C.C.

10-23-85
RECEIVED

Important procedures to follow:


STATE CORPORATION COMMISSION Notify District office before setting surface casing.

A Regular Section of Land
1 Mile = 5,280 Ft.

OCT 23 1985

CONSERVATION DIVISION

Wichita, Kansas

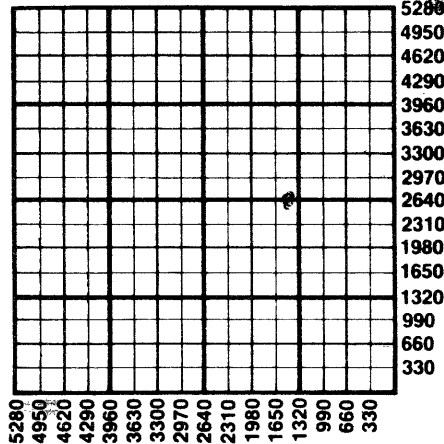

2. Set surface casing by circulating cement to the top.
3. File completion forms ACO-1 with K.C.C. within 90 days of well completion, following instructions on ACO-1, side 1, and including copies of wireline logs.
4. Notify District office 48 hours prior to old well workover or re-entry.
5. Prior to filing Intent, prepare a proposed plugging plan in case well is D & A, then obtain approval of plan when calling district office prior to setting surface pipe.
6. Submit plugging report (CP-4) to K.C.C. after plugging is completed.
7. Obtain an approved injection docket number before disposing of salt water.
8. Notify K.C.C. within 10 days when injection commences or terminates.
9. If an alternate 2 completion, cement in the production pipe from below any usable water to surface within 120 days of spud date.

State Corporation Commission of Kansas
Conservation Division
200 Colorado Derby Building
Wichita, Kansas 67202
(316) 263-3238