

CARD MUST BE TYPED

State of Kansas
NOTICE OF INTENTION TO DRILL
(see rules on reverse side)

^{2nd} Spot Location Change
CARD MUST BE SIGNED

Starting Date: 11 5 84
month day year

API Number 15- 207-25,071 - 00-00

OPERATOR: License # 5948

Name Tremo Corporation

Address Route #1 Box 82

City/State/Zip Toronto, Kansas 66777

Contact Person Tom Whiteman

Phone 316/637-2340

CONTRACTOR: License # 5913

Name Alco Drlg. Co.

City/State R. #3 Iola, Kansas 66749

Well Drilled For: Well Class: Type Equipment:

☒ Oil ☐ Swd ☒ Infield ☒ Mud Rotary

☒ Gas ☐ Inj ☐ Pool Ext. ☐ Air Rotary

☐ OWWO ☐ Expl ☐ Wildcat ☐ Cable

If OWWO: old well info as follows:

Operator

Well Name

Comp Date Old Total Depth

Projected Total Depth 1500 feet

Projected Formation at TD Bartlesville

Expected Producing Formations "

I certify that we will comply with K.S.A. 55-101, et seq., plus eventually plugging hole to K.C.C. specifications.

Date 10-25-84
Signature of Operator or Agent

*C SE NW SE Sec 4 Twp 25 S, Rge 14 ☒ East
(location) ☐ West

* 1650 Ft North from Southeast Corner of Section

* 1650 Ft West from Southeast Corner of Section
(Note: Locate well on Section Plat on reverse side)

Nearest lease or unit boundary line 990 feet.

County Woodson

Lease Name Bird Ranch Well# 21

Domestic well within 330 feet: ☐ yes ☒ no

Municipal well within one mile: ☐ yes ☒ no

Depth to Bottom of fresh water 25 feet

Lowest usable water formation Quarternary

Depth to Bottom of usable water 150 feet

Surface pipe by Alternate: 1 ☐ 2 ☒

Surface pipe to be set 40 feet

Conductor pipe if any required NONE

Ground surface elevation 1136 feet MSL

This Authorization Expires 4-3-85


Approved By 10-23-84
4025 CS 12 SW 1/4 3-25-14E
330 FSL 4620 FEL

Title MGR

Must be filed with the K.C.C. five (5) days prior to commencing well
This card void if drilling not started within six (6) months of date received by K.C.C.

Important procedures to follow :

**A Regular Section of Land
1 Mile = 5,280 Ft.**

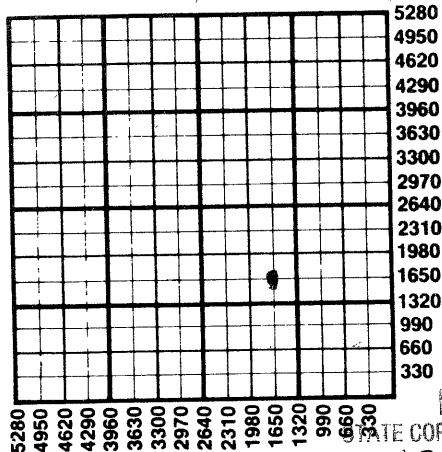

1. Notify District office before setting surface casing.
2. Set surface casing by circulating cement to the top.
3. File completion forms ACO-1 with K.C.C. within 90 days of well completion, following instructions on ACO-1, side 1, and including copies of wireline logs.
4. Notify District office 48 hours prior to old well workover or re-entry.
5. Prior to plugging, prepare a plugging plan, then obtain agreement from the appropriate district office for an approved plugging plan.
6. Submit plugging report (CP-4) to K.C.C. after plugging is completed.
7. Obtain an approved injection docket number before disposing of salt water.
8. Notify K.C.C. within 10 days when injection commences or terminates.
9. If an alternate 2 completion, cement in the production pipe from below any usable water to surface within 120 days of spud date.

RECEIVED

STATE CORPORATION COMMISSION

10-26-84
OCT 26 1984

CONSERVATION DIVISION
Wichita, Kansas

State Corporation Commission of Kansas
Conservation Division
200 Colorado Derby Building
Wichita, Kansas 67202
(316) 263-3238