

CARD MUST BE TYPED

State of Kansas

CARD MUST BE SIGNED

NOTICE OF INTENTION TO DRILL ^{24d}

SPOT LOCATION CHANGE

(see rules on reverse side)

Starting Date 12 10 85
month day year

API Number 15— 207-25,369 - ¹²⁶⁻⁸⁵ 0000

OPERATOR: License # 5596
Name Bird & Hanley
Address Route 1, Box 82
City/State/Zip Toronto, Kansas 66777
Contact Person Bob Hays
Phone 316/637-2340

* C S/2 SW Sec. 19... Twp. 25... S, Rg. 14... X East
* 660 Ft. from South Line of Section
* 3,960 Ft. from East Line of Section

(Note: Locate well on Section Plat on reverse side)

CONTRACTOR: License # 7721
Name Coconut Drilling Company
City/State Yates Center, Kansas 66783

Nearest lease or unit boundary line 660 feet
County Woodson
Lease Name Akins Well # 65
Ground surface elevation 984 feet MSL
Domestic well within 330 feet: yes X no
Municipal well within one mile: yes X no
Surface pipe by Alternate: 1 2 X
Depth to bottom of fresh water 25'
Depth to bottom of usable water 150'
Surface pipe planned to be set 40'
Projected Total Depth 1,500 feet
Formation Bartlesville

Well Drilled For: Well Class: Type Equipment:
X Oil _____ SWD X Infield X Mud Rotary
_____ Gas _____ Inj _____ Pool Ext. _____ Air Rotary
_____ OWWO _____ Expl _____ Wildcat _____ Cable

If OWWO: old well info as follows:

Operator
Well Name
Comp Date Old Total Depth

I certify that well will comply with K.S.A. 55-101, et seq., plus eventually plugging hole to KCC specifications.
and _____ cementing will be done immediately upon setting production casing.

SW SESE
was 535FSL
1195FEL

Date 12-5-85 Signature of Operator or Agent E. S. H. Q. Title Manager

For KCC Use:


Conductor Pipe Required feet: Minimum Surface Pipe Required feet per Alt. 1 2
This Authorization Expires 7-16-86 Approved By 8-16-85

Must be filed with the K.C.C. five (5) days prior to commencing well
This card void if drilling not started within six (6) months of date received by K.C.C.

Important procedures to follow:

1. Notify District office before setting surface casing.
2. Set surface casing by circulating cement to the top.
3. File completion forms ACO-1 with K.C.C. within 90 days of well completion, following instructions on ACO-1, side 1, and including copies of wireline logs.
4. Notify District office 48 hours prior to old well workover or re-entry.
5. Prior to filing Intent, prepare a proposed plugging plan in case well is D & A, then obtain approval of plan when calling district office prior to setting surface pipe.
6. Submit plugging report (CP-4) to K.C.C. after plugging is completed.
7. Obtain an approved injection docket number before disposing of salt water.
8. Notify K.C.C. within 10 days when injection commences or terminates.
9. If an alternate 2 completion, cement in the production pipe from below any usable water to surface within 120 days of spud date.

A Regular Section of Land 1 Mile = 5,280 Ft.

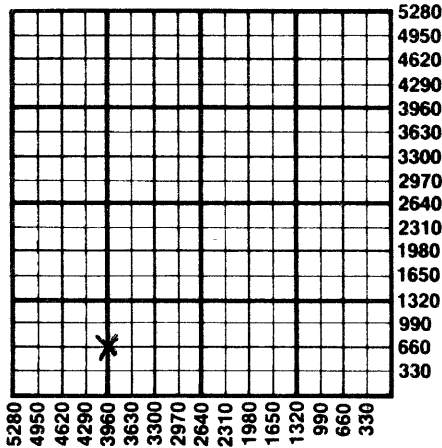

RECEIVED
STATE CORPORATION COMMISSION

DEC 6 1985
12-6-85
CONSERVATION DIVISION
Wichita, Kansas

State Corporation Commission of Kansas
Conservation Division
200 Colorado Derby Building
Wichita, Kansas 67202
(316) 263-3238