

CARD MUST BE TYPED

State of Kansas
NOTICE OF INTENTION TO DRILL

(see rules on reverse side)

CARD MUST BE SIGNED

CORRECTION
SPOT LOCATION CHANGE

Starting Date 9-20-85
month day year

API Number 15- 207-25,371 -00-00
9-23-85

OPERATOR: License # 5596
Name Bird & Hanley
Address Route #1 Box 82
City/State/Zip Toronto, Kansas 66777
Contact Person Bob Hays
Phone 316/637-2340

* SE SW SE Sec. 19 Twp. 25 S, Rg. 14 X East
* 165 Ft. from South Line of Section
* 1485 Ft. from East Line of Section

(Note: Locate well on Section Plat on reverse side)

CONTRACTOR: License # 5650
Name Kilby Drilling Company
City/State 705 South Pratt, Yates Center, KS

Nearest lease or unit boundary line 165 feet
County Woodson
Lease Name Akins Well # 67
Ground surface elevation 995 feet MSL

Well Drilled For: Well Class: Type Equipment:
 Oil SWD Infield Mud Rotary
 Gas Inj Pool Ext. Air Rotary
 OWWO Expl Wildcat Cable

Domestic well within 330 feet: _____ yes no
Municipal well within one mile: _____ yes no
Surface pipe by Alternate: 1 _____ 2 _____

If OWWO: old well info as follows:

Operator
Well Name
Comp Date Old Total Depth.....

Depth to bottom of fresh water 150
Depth to bottom of usable water 40
Surface pipe planned to be set 40
Projected Total Depth 1500 feet
Formation Bartlesville

I certify that well will comply with K.S.A. 55-101, et seq., plus eventually plugging hole to KCC specifications.

_____ cementing will be done immediately upon setting production casing.

Date 9-20-85 Signature of Operator or Agent Title Manager
SESESE
1485 FSL
165 FSL

For KCC Use:


Conductor Pipe Required feet: Minimum Surface Pipe Required feet per Alt. 1 2
This Authorization Expires 2-16-86 Approved By 2-16-85

Must be filed with the K.C.C. five (5) days prior to commencing well
This card void if drilling not started within six (6) months of date received by K.C.C.

Important procedures to follow:

1. Notify District office before setting surface casing.
2. Set surface casing by circulating cement to the top.
3. File completion forms ACO-1 with K.C.C. within 90 days of well completion, following instructions on ACO-1, side 1, and including copies of wireline logs.
4. Notify District office 48 hours prior to old well workover or re-entry.
5. Prior to filing Intent, prepare a proposed plugging plan in case well is D & A, then obtain approval of plan when calling district office prior to setting surface pipe.
6. Submit plugging report (CP-4) to K.C.C. after plugging is completed.
7. Obtain an approved injection docket number before disposing of salt water.
8. Notify K.C.C. within 10 days when injection commences or terminates.
9. If an alternate 2 completion, cement in the production pipe from below any usable water to surface within 120 days of spud date.

A Regular Section of Land
1 Mile = 5,280 Ft.

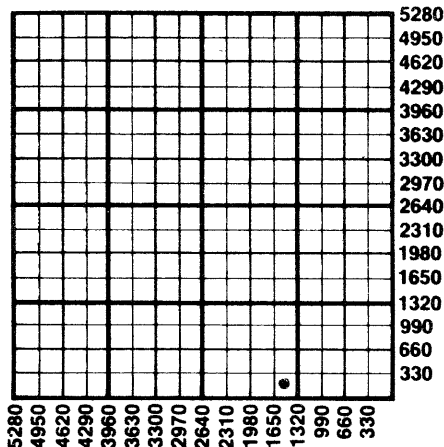

RECEIVED
STATE CORPORATION COMMISSION

SEP 23 1985
9-23-85
CONSERVATION DIVISION
Wichita, Kansas

State Corporation Commission of Kansas
Conservation Division
200 Colorado Derby Building
Wichita, Kansas 67202
(316) 263-3238