

CARD MUST BE TYPED

State of Kansas

CARD MUST BE SIGNED

NOTICE OF INTENTION TO DRILL

(see rules on reverse side)

Starting Date 9 11 85
month day year

API Number 15— 207-25,381-0000

OPERATOR: License # 5596
Name Bird & Hanley
Address Route 1, Box 82
City/State/Zip Toronto, Kansas 66777
Contact Person Bob Hays
Phone 316/637-2340

NE SW SE Sec. 19 Twp. 25 S, Rg. 14 East
825 West
1,485 Ft. from South Line of Section
Ft. from East Line of Section

(Note: Locate well on Section Plat on reverse side)

CONTRACTOR: License # 7721
Name Coconut Drilling, Inc.
City/State Yates Center, Kansas 66783

Nearest lease or unit boundary line 825 feet
County Woodson

Lease Name Akins Well # 71

Ground surface elevation 1,000' feet MSL

Well Drilled For: Well Class: Type Equipment:
 Oil SWD Infield Mud Rotary
 Gas Inj Pool Ext. Air Rotary
 OWWO Expl Wildcat Cable

Domestic well within 330 feet: —yes no

Municipal well within one mile: —yes no

Surface pipe by Alternate: 1 2

Depth to bottom of fresh water 25'

Depth to bottom of usable water 150'

Surface pipe planned to be set 40'

Projected Total Depth 1,500 feet

Formation Bartlesville

If OWWO: old well info as follows:

Operator

Well Name

Comp Date Old Total Depth

I certify that well will comply with K.S.A. 55-101, et seq., plus eventually plugging hole to KCC specifications.

_____ cementing will be done immediately upon setting production casing.

Date 8-27-85 Signature of Operator or Agent Title Manager

For KCC Use:

Conductor Pipe Required feet; Minimum Surface Pipe Required feet per ft. 1 2

This Authorization Expires 2-29-86 Approved By 8-29-85

RCM for KONE

Must be filed with the K.C.C. five (5) days prior to commencing well
 This card void if drilling not started within six (6) months of date received by K.C.C.

8-29-85

Important procedures to follow:

RECEIVED
 STATE CORPORATION COMMISSION

1. Notify District office before setting surface casing.


A Regular Section of Land
1 Mile = 5,280 Ft.

AUG 29 1985

2. Set surface casing by circulating cement to the top.

CONSERVATION DIVISION
 Wichita, Kansas

3. File completion forms ACO-1 with K.C.C. within 90 days of well completion, following instructions on ACO-1, side 1, and including copies of wireline logs.

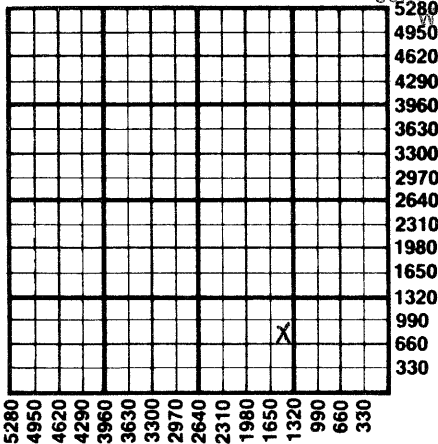

4. Notify District office 48 hours prior to old well workover or re-entry.

5. Prior to filing Intent, prepare a proposed plugging plan in case well is D & A, then obtain approval of plan when calling district office prior to setting surface pipe.

6. Submit plugging report (CP-4) to K.C.C. after plugging is completed.

7. Obtain an approved injection docket number before disposing of salt water.

8. Notify K.C.C. within 10 days when injection commences or terminates.

9. If an alternate 2 completion, cement in the production pipe from below any usable water to surface within 120 days of spud date.

State Corporation Commission of Kansas
 Conservation Division
 200 Colorado Derby Building
 Wichita, Kansas 67202
 (316) 263-3238