

CARD MUST BE TYPED

State of Kansas  
**NOTICE OF INTENTION TO DRILL**

CARD MUST BE SIGNED

(see rules on reverse side)

Starting Date: October 15 1984  
month day year

API Number 15- 207-25,057-00-00

OPERATOR: License # 5647  
Name Marion Myers  
Address P.O. Box 284  
City/State/Zip Eureka, Kansas 67045  
Contact Person Marion Myers  
Phone 583-6480

~~SW SE NW~~  
~~DEBESVILLE~~ (location) Sec 22 Twp 25 S, Rge 14  East  West

~~3970~~ Ft North from Southeast Corner of Section  
~~3405~~ Ft West from Southeast Corner of Section  
(Note: Locate well on Section Plat on reverse side)

CONTRACTOR: License # 5650  
Name Kilby Drlg  
City/State Yates Cntr, Ks. 66783

Nearest lease or unit boundary line 330 feet.

County Woodson

Lease Name Griffith Well# 10

Domestic well within 330 feet:  yes  no

Municipal well within one mile:  yes  no

Well Drilled For: Well Class: Type Equipment:  
 Oil  Swd  Infield  Mud Rotary  
 Gas  Inj  Pool Ext.  Air Rotary  
 OWWO  Expl  Wildcat  Cable

Depth to Bottom of fresh water 100 feet

Lowest usable water formation 100

Depth to Bottom of usable water 110 150 feet

Surface pipe by Alternate: 1  2

Surface pipe to be set 150 feet

Conductor pipe if any required none feet

Ground surface elevation \_\_\_\_\_ feet MSL

This Authorization Expires 3-25-85

Approved By 9-25-84 RM

I certify that we will comply with K.S.A. 55-101, et seq., plus eventually plugging hole to K.C.C. specifications.


Date 9-24-84 Signature of Operator or Agent Marion Myers title Owner

#10

Must be filed with the K.C.C. five (5) days prior to commencing well  
This card void if drilling not started within six (6) months of date received by K.C.C.

9-25-84  
SEP 25 1984

**A Regular Section of Land  
1 Mile = 5,280 Ft.**

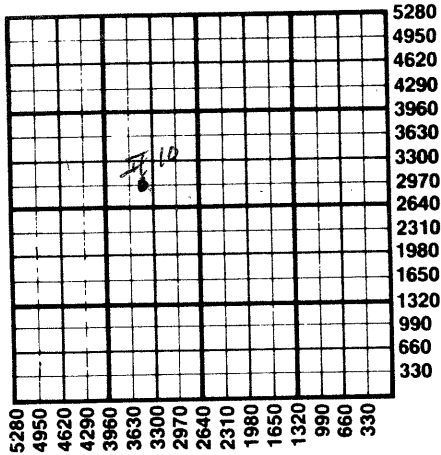

**Important procedures to follow:**

1. Notify District office before setting surface casing.
2. Set surface casing by circulating cement to the top.
3. File completion forms ACO-1 with K.C.C. within 90 days of well completion, following instructions on ACO-1, side 1, and including copies of wireline logs.
4. Notify District office 48 hours prior to old well workover or re-entry.
5. Prior to plugging, prepare a plugging plan, then obtain agreement from the appropriate district office for an approved plugging plan.
6. Submit plugging report (CP-4) to K.C.C. after plugging is completed.
7. Obtain an approved injection docket number before disposing of salt water.
8. Notify K.C.C. within 10 days when injection commences or terminates.
9. If an alternate 2 completion, cement in the production pipe from below any usable water to surface within 120 days of spud date.

**State Corporation Commission of Kansas  
Conservation Division  
200 Colorado Derby Building  
Wichita, Kansas 67202  
(316)263-3238**