

CARD MUST BE TYPED

State of Kansas
NOTICE OF INTENTION TO DRILL
(see rules on reverse side)

CARD MUST BE SIGNED

Starting Date: May 20, 1985
month day year

OPERATOR: License # 5983
Name Victor J. Leis D & Co.
Address POB 223
City/State/Zip Yates Center, KS 66783
Contact Person Victor J. Leis
Phone 316-625-2106

CONTRACTOR: License #
Name Unknown
City/State

Well Drilled For:	Well Class:	Type Equipment:
<input checked="" type="checkbox"/> Oil	<input checked="" type="checkbox"/> Infield	<input checked="" type="checkbox"/> Mud Rotary
<input type="checkbox"/> Gas	<input type="checkbox"/> Pool Ext.	<input type="checkbox"/> Air Rotary
<input type="checkbox"/> OWWO	<input type="checkbox"/> Wildcat	<input type="checkbox"/> Cable

If OWWO: old well info as follows:

Operator
Well Name
Comp Date Old Total Depth
Projected Total Depth 1600 feet
Projected Formation at TD
Expected Producing Formations

I certify that we will comply with K.S.A. 55-101, et seq., plus eventually plugging hole to K.C.C. specifications.

May 10, 1985

Date Signature of Operator or Agent

API Number 15-207-25,270-0000

SW SW SE Sec 22 Twp 25 S, Rge 14
(location) ☒ East ☐ West

165 Ft North from Southeast Corner of Section
2475 Ft West from Southeast Corner of Section
(Note: Locate well on Section Plat on reverse side)

Nearest lease or unit boundary line 165 feet.
County Woodson
Lease Name Tipton Well # 1

Domestic well within 330 feet: ☐ yes ☒ no
Municipal well within one mile: ☐ yes ☒ no

Depth to Bottom of fresh water 15 feet
Lowest usable water formation N/A
Depth to Bottom of usable water 150 feet
Surface pipe by Alternate: 1 ☐ 2 ☒
Surface pipe to be set 40 feet
Conductor pipe if any required none feet
Ground surface elevation N/A feet MSL
This Authorization Expires 11-13-85
Approved By 5-13-85 R


Owner

MHC/KDHE 5-13-85

Must be filed with the K.C.C. five (5) days prior to commencing well
This card void if drilling not started within six (6) months of date received by K.C.C.

Important procedures to follow :

A Regular Section of Land
1 Mile = 5,280 Ft.

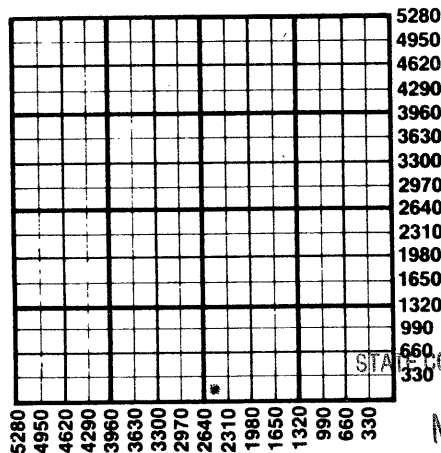

1. Notify District office before setting surface casing.
2. Set surface casing by circulating cement to the top.
3. File completion forms ACO-1 with K.C.C. within 90 days of well completion, following instructions on ACO-1, side 1, and including copies of wireline logs.
4. Notify District office 48 hours prior to old well workover or re-entry.
5. Prior to plugging, prepare a plugging plan, then obtain agreement from the appropriate district office for an approved plugging plan.
6. Submit plugging report (CP-4) to K.C.C. after plugging is completed.
7. Obtain an approved injection docket number before disposing of salt water.
8. Notify K.C.C. within 10 days when injection commences or terminates.
9. After terminate 2 completion, cement in the production pipe from below any usable water to surface within 120 days of spud date.

RECEIVED
STATE CORPORATION COMMISSION

MAY 13 1985

CONSERVATION DIVISION
Wichita, Kansas

5-13-85

State Corporation Commission of Kansas
Conservation Division
200 Colorado Derby Building
Wichita, Kansas 67202
(316) 263-3238