

CARD MUST BE TYPED

State of Kansas NOTICE OF INTENTION TO DRILL

(see rules on reverse side)

CARD MUST BE SIGNED

Starting Date: July 6 1984
month day year

OPERATOR: License # 7830
Name Mecca Petroleum Corp.
Address 140 E. 19th Av., Suite 500
City/State/Zip Denver, CO 80202
Contact Person Pamela R. Woodwell
Phone (303) 830-7071

CONTRACTOR: License # 8827
Name Treat-Rite Water Labs
City/State Nowata, OK

Well Drilled For:	Well Class:	Type Equipment:
<input type="checkbox"/> Oil	<input checked="" type="checkbox"/> Swd	<input type="checkbox"/> Mud Rotary
<input type="checkbox"/> Gas	<input type="checkbox"/> Inj	<input checked="" type="checkbox"/> Air Rotary
<input type="checkbox"/> OWFO	<input type="checkbox"/> Expl	<input type="checkbox"/> Cable
	<input type="checkbox"/> Wildcat	

If OWFO: old well info as follows:

Operator
Well Name
Comp Date Old Total Depth
Projected Total Depth 645' feet
Projected Formation at TD Kansas City
Expected Producing Formations N/A

I certify that we will comply with K.S.A. 55-101, et seq., plus eventually plugging hole to K.C.C. specifications.

Date 7/3/84 Signature of Operator or Agent Pamela R. Woodwell Title Geologist

API Number 15-

207-24,934-0000

SW SE SW SE Sec 26 Twp 25 S, Rge 14 East
(location) West

..... 165' Ft North from Southeast Corner of Section
..... 1920' Ft West from Southeast Corner of Section
(Note: Locate well on Section Plat on reverse side)

Nearest lease or unit boundary line 165' feet.

County Woodson

Lease Name Sheedy Well# SWDW 1

Domestic well within 330 feet: ☐ yes ☒ noMunicipal well within one mile: ☐ yes ☒ no

Depth to Bottom of fresh water 150 feet

Lowest usable water formation None

Depth to Bottom of usable water 250 feet

Surface pipe by Alternate: 1 ☐ 2 ☒

Surface pipe to be set 48' feet

Conductor pipe if any required None

Ground surface elevation 1004 feet MSL


This Authorization Expires 1/5/85

Approved By 7/5/84 *Re*

Must be filed with the K.C.C. five (5) days prior to commencing well
This card void if drilling not started within six (6) months of date received by K.C.C.

Important procedures to follow :

A Regular Section of Land 1 Mile = 5,280 Ft.

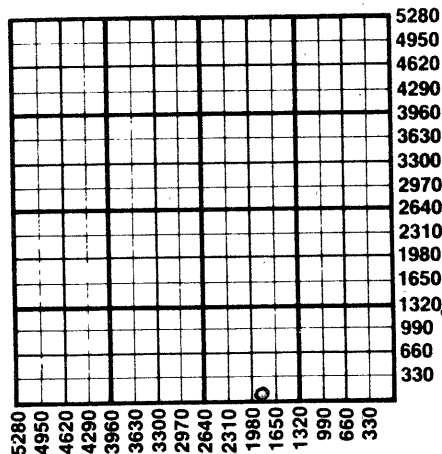

1. Notify District office before setting surface casing.
 2. Set surface casing by circulating cement to the top.
 3. File completion forms ACO-1 with K.C.C. within 90 days of well completion, following instructions on ACO-1, side 1, and including copies of wireline logs.
 4. Notify District office 48 hours prior to old well workover or re-entry.
 5. Prior to plugging, prepare a plugging plan, then obtain agreement from the appropriate district office for an approved plugging plan.
 6. Submit plugging report (CP-4) to K.C.C. after plugging is completed.
 7. Obtain an approved injection docket number before disposing of salt water.
- Notify K.C.C. within 10 days when injection commences or terminates.
Alternate 2 completion, cement in the production pipe from below any usable water to surface within 120 days of spud date.

RECEIVED
STATE CORPORATION COMMISSION
MAY 05 1984
CONSERVATION DIVISION
Wichita, Kansas
7-5-84

State Corporation Commission of Kansas
Conservation Division
200 Colorado Derby Building
Wichita, Kansas 67202
(316) 263-3238