

CARD MUST BE TYPED

State of Kansas
NOTICE OF INTENTION TO DRILL
(see rules on reverse side)

CARD MUST BE SIGNED

Collected
5-22-85

Starting Date: May 8 1985
month day year

API Number 15-207-25,262-00-00
CORRECTION

OPERATOR: License # 5051 & 5602
Name Reed Oil Company & N&B Enterprises
Address 1 S. Lincoln P.O. Box 2
City/State/Zip Chanute, Kansas 66720
Contact Person James E. Guinotte
Phone (316) 431-4130

SE SE NE... Sec 26.. Twp 25. S, Rge 14. East
 West
* 2860..... Ft North from Southeast Corner of Section
* 220..... Ft West from Southeast Corner of Section
(Note: Locate well on Section Plat on reverse side)

CONTRACTOR: License # 5677
Name J.R. Burriss Drlg. Co.
City/State Iola, Kansas

Nearest lease or unit boundary line 220 feet.
County Woodson
Lease Name Sheedy Well# 1

Domestic well within 330 feet: yes no
Municipal well within one mile: yes no

Well Drilled For: Well Class: Type Equipment:
 Oil Swd Infield Mud Rotary
 Gas Inj Pool Ext. Air Rotary
 OWWO Expl Wildcat Cable

Depth to Bottom of fresh water 20 feet
Lowest usable water formation None
Depth to Bottom of usable water 150 feet
Surface pipe by Alternate: 1 2
Surface pipe to be set 40 feet
Conductor pipe if any required None feet
Ground surface elevation Unknown feet MSL
This Authorization Expires 10-30-85
Approved By

If OWWO: old well info as follows:
Operator
Well Name
Comp Date Old Total Depth
Projected Total Depth 1900 feet
Projected Formation at TD Arbuckle
Expected Producing Formations Arbuckle

I certify that we will comply with K.S.A. 55-101, et seq., plus eventually plugging hole to K.C.C. specifications.

Date 5/21/85 Signature of Operator or Agent

James E. Guinotte Title President, Reed Oil Co.
Kws. 2860 FEL

RECEIVED

STATE CORPORATION COMMISSION

Must be filed with the K.C.C. five (5) days prior to commencing well
This card void if drilling not started within six (6) months of date received by K.C.C.


MAY 22 1985

522-85

CONSERVATION DIVISION

Wichita, Kansas
A Regular Section of Land

1 Mile = 5,280 Ft.

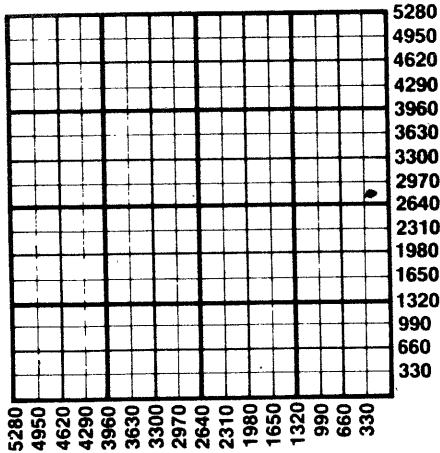

Important procedures to follow :

1. Notify District office before setting surface casing.
2. Set surface casing by circulating cement to the top.
3. File completion forms ACO-1 with K.C.C. within 90 days of well completion, following instructions on ACO-1, side 1, and including copies of wireline logs.
4. Notify District office 48 hours prior to old well workover or re-entry.
5. Prior to plugging, prepare a plugging plan, then obtain agreement from the appropriate district office for an approved plugging plan.
6. Submit plugging report (CP-4) to K.C.C. after plugging is completed.
7. Obtain an approved injection docket number before disposing of salt water.
8. Notify K.C.C. within 10 days when injection commences or terminates.
9. If an alternate 2 completion, cement in the production pipe from below any usable water to surface within 120 days of spud date.

State Corporation Commission of Kansas
 Conservation Division
 200 Colorado Derby Building
 Wichita, Kansas 67202
 (316) 263-3238