

CARD MUST BE TYPED

State of Kansas
NOTICE OF INTENTION TO DRILL
(see rules on reverse side)

CORRECTION
CARD MUST BE SIGNED

Starting Date: May 20 1985
month day year

API Number 15-

OPERATOR: License # 5051 & 5602

Name Reed Oil Co. & N&B Enterprises

Address 1 S. Lincoln P.O. Box 2

City/State/Zip Chanute, Kansas 66720

Contact Person James F. Guinotte

Phone (316) 431-4130

CONTRACTOR: License # 5677

Name J. R. Burris Drilling Co.

City/State Iola, Kansas

Well Drilled For:

Well Class:

Type Equipment:

☒ Oil ☐ Swd☐ Infield☒ Mud Rotary☐ Gas ☐ Inj☒ Pool Ext.☐ Air Rotary☐ OWWO ☐ Expl☐ Wildcat☐ Cable

If OWWO: old well info as follows:

Operator

Well Name

Comp Date

Old Total Depth

Projected Total Depth 1900 feet

Projected Formation at TD Arbuckle

Expected Producing Formations Arbuckle

I certify that we will comply with K.S.A. 55-101, et seq., plus eventually plugging hole to K.C.C. specifications.

Date 5/21/85 Signature of Operator or Agent

API Number 15-

* 5/2 SE NE. Sec 26. Twp 25. S, Rge 14. ☒ East
(location) ☐ West

* 2860 Ft North from Southeast Corner of Section
660 Ft West from Southeast Corner of Section
(Note: Locate well on Section Plat on reverse side)

Nearest lease or unit boundary line 220 feet.

County Woodson

Lease Name Sheedy Well# 2

Domestic well within 330 feet: ☐ yes ☒ noMunicipal well within one mile: ☐ yes ☒ no

Depth to Bottom of fresh water 20 feet

Lowest usable water formation None

Depth to Bottom of usable water 150 feet

Surface pipe by Alternate: 1 ☐ 2 ☒

Surface pipe to be set 40 feet

Conductor pipe if any required None feet

Ground surface elevation Unknown feet MSL

This Authorization Expires 11-15-85

Approved By 5-15-85

Two 5" ~~4" to 5" 3300 FEL~~

President, Reed Oil Co.


RECEIVED
STATE CORPORATION COMMISSION

Must be filed with the K.C.C. five (5) days prior to commencing well
This card void if drilling not started within six (6) months of date received by K.C.C.

MAY 22 1985

5-22-85

A Regular Section of Land
1 Mile 5,280 Ft.

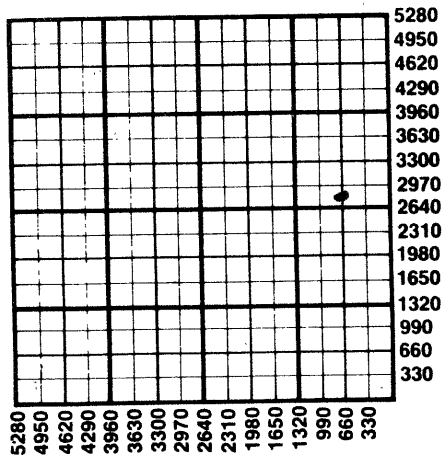

Important procedures to follow :

1. Notify District office before setting surface casing.
2. Set surface casing by circulating cement to the top.
3. File completion forms ACO-1 with K.C.C. within 90 days of well completion, following instructions on ACO-1, side 1, and including copies of wireline logs.
4. Notify District office 48 hours prior to old well workover or re-entry.
5. Prior to plugging, prepare a plugging plan, then obtain agreement from the appropriate district office for an approved plugging plan.
6. Submit plugging report (CP-4) to K.C.C. after plugging is completed.
7. Obtain an approved injection docket number before disposing of salt water.
8. Notify K.C.C. within 10 days when injection commences or terminates.
9. If an alternate 2 completion, cement in the production pipe from below any usable water to surface within 120 days of spud date.

State Corporation Commission of Kansas
Conservation Division
200 Colorado Derby Building
Wichita, Kansas 67202
(316) 263-3238