

CARD MUST BE TYPED

State of Kansas

CARD MUST BE SIGNED

NOTICE OF INTENTION TO DRILL

(see rules on reverse side)

Starting Date Nov. 1, 1985
month day year *11 45*

OPERATOR: License # 5647
Name Marion Myers
Address P.O. Box 284
City/State/Zip Eureka, KS 67045
Contact Person Marion Myers
Phone (316) 583-6480

CONTRACTOR: License # 5650
Name Kilby Drilling
City/State Yates Center, KS

Well Drilled For: Well Class: Type Equipment:
 Oil SWD Infield Mud Rotary
 Gas Inj Pool Ext. Air Rotary
 OWWO Expl Wildcat Cable

If OWWO: old well info as follows:
Operator
Well Name
Comp Date Old Total Depth.....

I certify that well will comply with K.S.A. 55-101, et seq., plus eventually plugging hole to KCC specifications.

Alt. cementing will be done immediately upon setting production casing.
Date 11/1/85 Signature of Operator or Agent *Jesse Arnold* Title. As Agent *Ret/NOAC*

For KCC Use:
Conductor Pipe Required feet; Minimum Surface Pipe Required feet per Alt. 1 2
This Authorization Expires 5-2-86 Approved By 11-1-85

API Number 15- *207-25, 414-00-00*
app. ~~NE~~ ^{NE} NW 29 Twp. 25 S, Rg. 14 East
4945 Ft. from South Line of Section
3000 Ft. from East Line of Section

(Note: Locate well on Section Plat on reverse side)

Nearest lease or unit boundary line 360 feet
County Woodson
Lease Name Corkery Well # 17
Ground surface elevation na feet MSL
Domestic well within 330 feet: yes no
Municipal well within one mile: yes no
Surface pipe by Alternate:
Depth to bottom of fresh water 85
Depth to bottom of usable water ~~100~~ 150
Surface pipe planned to be set 150
Projected Total Depth 1420 feet
Formation Bartlesville

Must be filed with the K.C.C. five (5) days prior to commencing well
This card void if drilling not started within six (6) months of date received by K.C.C.


RECEIVED
STATE CORPORATION COMMISSION

11-1-85

Important procedures to follow:

A Regular Section of Land 1 1985
1 Mile = 5,280 Ft.

CONSERVATION DIVISION
Wichita, Kansas

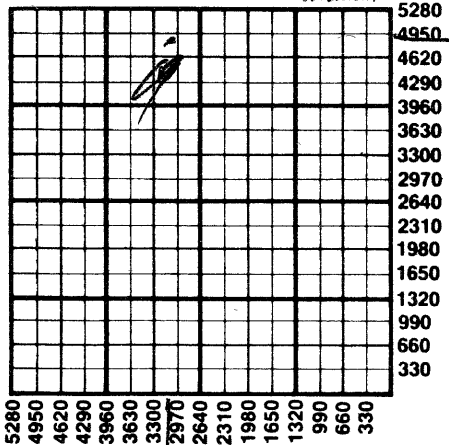

1. Notify District office before setting surface casing.
2. Set surface casing by circulating cement to the top.
3. File completion forms ACO-1 with K.C.C. within 90 days of well completion, following instructions on ACO-1, side 1, and including copies of wireline logs.
4. Notify District office 48 hours prior to old well workover or re-entry.
5. Prior to filing Intent, prepare a proposed plugging plan in case well is D & A, then obtain approval of plan when calling district office prior to setting surface pipe.
6. Submit plugging report (CP-4) to K.C.C. after plugging is completed.
7. Obtain an approved injection docket number before disposing of salt water.
8. Notify K.C.C. within 10 days when injection commences or terminates.
9. If an alternate 2 completion, cement in the production pipe from below any usable water to surface within 120 days of spud date.

State Corporation Commission of Kansas
Conservation Division
200 Colorado Derby Building
Wichita, Kansas 67202
(316) 263-3238