

CARD MUST BE TYPED

State of Kansas  
**NOTICE OF INTENTION TO DRILL**  
(see rules on reverse side)

CARD MUST BE SIGNED

Starting Date: 2-28-85  
month day year

OPERATOR: License # 9036  
Name Oakridge Enterprises

Address K.B.R. #1  
City/State/Zip Yates Center, KS

Contact Person Larry C. Martin  
Phone 316-625-3334

CONTRACTOR: License # 9430  
Name CMT...Petra Resources, Inc.  
City/State Canton, Mo. 63435

Well Drilled For:		Well Class:	Type Equipment:
<input checked="" type="checkbox"/> Oil	<input type="checkbox"/> Swd	<input type="checkbox"/> Infield	<input checked="" type="checkbox"/> Mud Rotary
<input type="checkbox"/> Gas	<input type="checkbox"/> Inj	<input type="checkbox"/> Pool Ext.	<input type="checkbox"/> Air Rotary
<input type="checkbox"/> OWWO	<input type="checkbox"/> Expl	<input checked="" type="checkbox"/> Wildcat	<input type="checkbox"/> Cable

If OWWO: old well info as follows:

Operator

Well Name

Comp Date Old Total Depth

Projected Total Depth 1500. feet

Projected Formation at TD Bartlesville

Expected Producing Formations Bartlesville

I certify that we will comply with K.S.A. 55-101, et seq., plus eventually plugging hole to K.C.C. specifications.

Date 2-25-85  
Signature of Operator or Agent

API Number 15- 207-25,214-00-00  
S.W. 1/4 Sec. 35 Twp. 25 S, Rge. 14  
(location)

☒ East☐ West

175. Ft North from Southeast Corner of Section  
5105. Ft West from Southeast Corner of Section  
(Note: Locate well on Section Plat on reverse side)

Nearest lease or unit boundary line 175. feet.  
County Woodson

Lease Name Ianham Well# 4

Domestic well within 330 feet: ☐ yes ☒ noMunicipal well within one mile: ☐ yes ☒ no

Depth to Bottom of fresh water Unknown feet

Lowest usable water formation Unknown

Depth to Bottom of usable water Unknown 150 feet

Surface pipe by Alternate: 1 ☐ 2 ☒

Surface pipe to be set 40 feet

Conductor pipe if any required none. feet

Ground surface elevation Unknown. feet MSL

This Authorization Expires 8-28-85

Approved By 2-28-85

Date 2-25-85  
Signature of Operator or Agent Larry C. Martin Title operator


Form C-1 4/84

MHC/NOHE 2-28-85

**Must be filed with the K.C.C. five (5) days prior to commencing well  
This card void if drilling not started within six (6) months of date received by K.C.C.**

**Important procedures to follow :**

**A Regular Section of Land  
1 Mile = 5,280 Ft.**

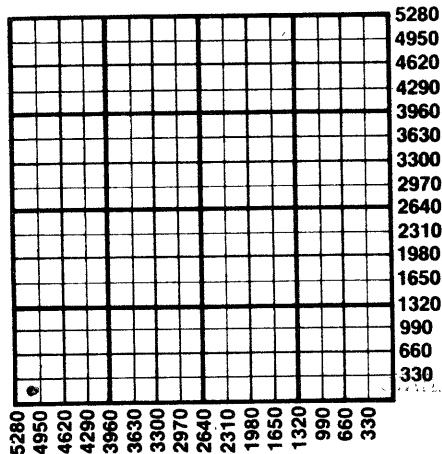

1. Notify District office before setting surface casing.
2. Set surface casing by circulating cement to the top.
3. File completion forms ACO-1 with K.C.C. within 90 days of well completion, following instructions on ACO-1, side 1, and including copies of wireline logs.
4. Notify District office 48 hours prior to old well workover or re-entry.
5. Prior to plugging, prepare a plugging plan, then obtain agreement from the appropriate district office for an approved plugging plan.
6. Submit plugging report (CP-4) to K.C.C. after plugging is completed.
7. Obtain an approved injection docket number before disposing of salt water.
8. Notify K.C.C. within 10 days when injection commences or terminates.
9. If an alternate 2 completion, cement in the production pipe from below any usable water to surface within 120 days of spud date.

FEB 28 1985

State Corporation Commission of Kansas  
Conservation Division  
200 Colorado Derby Building  
Wichita, Kansas 67202  
(316) 263-3238

2-28-85