Amending location footage API #15-023-20703-0000

For KCC Use: Effective Date:	9-606
District #	L
SGA? Yes	'I⊋' No

KANSAS CORPORATION COMMISSION OIL & GAS CONSERVATION DIVISION

December 2002 NOTICE OF INTENT TO DRILL

Must be approved by KCC five (5) days prior to commencing well





Form must be Signed must be Filled

Form C-1

Expected Spud Date	Spot
22225	—
OPERATOR: License# 33325	760 teet from N / S Line of Section 1035 feet from V E / W Line of Section
Name: Petroleum Development Corporation Address: 103 E. Main Street, PO Box 26	, — —
Address: No L. Wall Steet, FO Box 20	Is SECTIONRegular irregular?
City/State/Zip: Bridgeport, WV 26330	(Note: Locate well on the Section Plat on reverse side)
Contact Person, James Annable	County: Cheyenne
Phone: 303-905-4340	Lease Name: Feikert Well #: 44-7
8273 or 33532	Field Name: Cherry Creek Niobrara Gas Area
CONTRACTOR: License# 8273 or 33532	Is this a Prorated / Spaced Field?
lame: Excell Services, Inc. of Advanced Disting Technologies	Target Formation(s): Niobrara
Well Drilled For: Well Class; Type Equipment:	Nearest Lease or unit boundary: 760'
	Ground Surface Elevation: 3570' feet M
Oil Enh Rec Infield Mud Rotary	Water well within one-quarter mile: Yes √
✓ Gas Storage ✓ Pool Ext. Air Rotary	Public water supply well within one mile:
OWWO Disposal Wildcat Cable	Depth to bottom of fresh water: 200'
Seismic;# of Holes Other	
Other	Depth to bottom of usable water:
	Surface Pipe by Alternate: 1 1 2
OWWO: old well information as follows:	Length of Surface Pipe Planned to be set: 250'
Operator: NA	Length of Conductor Pipe required: NA
Well Name:	Projected Total Depth: 1620'
Original Completion Date:Original Total Depth:	Formation at Total Depth: Niobrara
	Water Source for Drilling Operations:
irectional, Deviated or Horizontal wellbore?	Well Farm Pond Other Drilling contractor will apply
Yes, true vertical depth:	DWR Permit #:
Nottom Hole Location:	
	(Note: Apply for Permit with DWR (Z)
CC DKT #:	Will Cores be taken? Yes ✓
























OCT - TOTAL KCC WICHITA

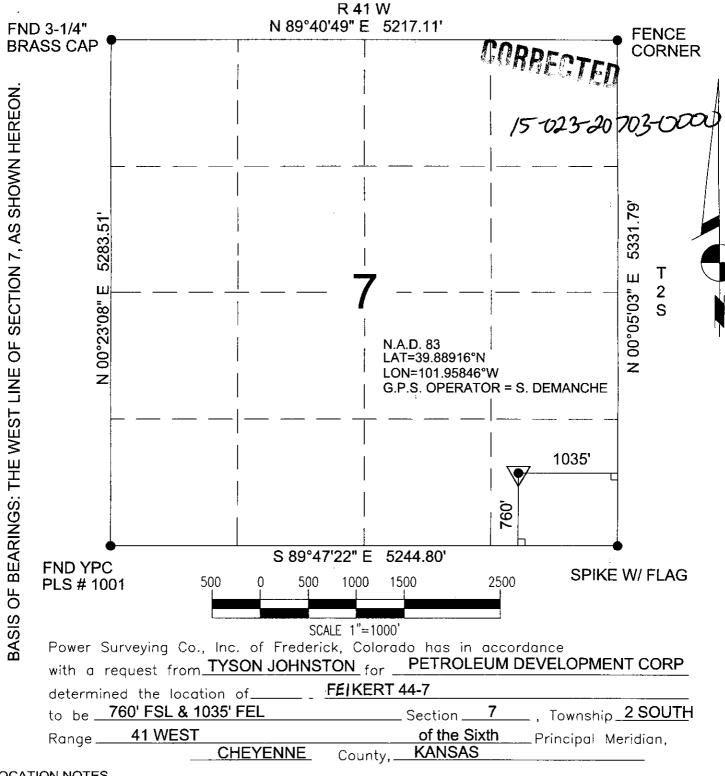

LOCATION NOTES

LOCATION FALLS IN: NATURAL GROUND

IMPROVEMENTS: NONE WITHIN 200' OF LOCATION

ELEVATION DETERMINED FROM NAVD 1988 DATUM. GROUND ELEVATION = 3570'

DISTANCES AND BEARINGS ARE FIELD MEASURED UNLESS OTHERWISE NOTED.

LEGEND

SECTION CORNER (AS NOTED)

lacksquare

PROPOSED WELL LOCATION





7800 MILLER DRIVE UNIT C FREDERICK, COLORADO 80504 303-702-1617

GCT - C

VCC V// CHI A 4-2006 WO# 501-06-889

FIELD DATE: 8-24-2006 WO# 501-06-889 DATE OF COMPLETION: 9-6-2006

KANSAS CORPORATION COMMISSION OIL & GAS CONSERVATION DIVISION

APPLICATION FOR SURFACE PIT

Form CDP-1
April 2004
Form must be Typed

CORRECTER

	Submit in Duplicate		· · · · · · · · · · · · · · · · · · ·	
Operator Name: Petroleum Development Corporation			License Number: 33325	
Operator Address: 103 E. Main Str	eet, PO Box	26 Bridge	oort, WV 26330	
Contact Person: James Annable			Phone Number: (303) 905 -4340	
Lease Name & Well No.: Feikert 44-7			Pit Location (QQQQ):	
Type of Pit:	Pit is: Proposed Existing If Existing, date constructed:		<u>Sw w/2 se se se</u>	
☐ Emergency Pit ☐ Burn Pit ☐ Settling Pit ☐ Drilling Pit			Sec. 7 Twp. 2S R 41 East West 760 Feet from North / South Line of Section	
Workover Pit Haul-Off Pit (If WP Supply API No. or Year Drilled)	Pit capacity:		Feet from ✓ East / West Line of Section Cheyenne County	
Is the pit located in a Sensitive Ground Water	Area? ☐ Yes ✓] No	Chloride concentration: mg/l (For Emergency Pits and Settling Pits only)	
Is the bottom below ground level? Yes No	Artificial Liner? ☐ Yes ✔ No		How is the pit lined if a plastic liner is not used? Natural Clay/bentonite	
	50 Length (fe	_	Width (feet) N/A: Steel Pits (feet)	
If the pit is lined give a brief description of the liner material, thickness and installation procedure.		Describe procedures for periodic maintenance and determining liner integrity, including any special monitoring.		
NA		NA 		
Distance to nearest water well within one-mile of pit		Depth to shallowest fresh water 119 feet. Source of information:		
1380feet Depth of water well130feet		measuredwell owner electric log KDWR		
Emergency, Settling and Burn Pits ONLY:		Drilling, Workover and Haul-Off Pits ONLY:		
Producing Formation:		Type of material utilized in drilling/workover: Bentonite mud		
Number of producing wells on lease:		Number of working pits to be utilized: 1		
Barrels of fluid produced daily: Abandor		Abandonment	procedure: Evaporation/backfill	
Does the slope from the tank battery allow all spilled fluids to flow into the pit? Yes No		Drill pits must be closed within 365 days of spud date.		
I hereby certify that the above stat	ements are true and o	correct to the bes	t of my knowledge and belief.	
10/4/2006 Date			GG Signature of Applicant or Agent	
,	KCC	OFFICE USE O	NLY	
Date Received: 10/5/55 Permit Nur	mber:	Perm	lit Date: (C/C/6/√√ Lease Inspection: ☐ Yes ☐ Ńo	

Mail to: KCC - Conservation Division, 130 S. Market - Room 2078, Wichita, Kansas 67202

RECEIVE

KCC WICHITA