

CARD MUST BE TYPED

A

State of Kansas  
NOTICE OF INTENTION TO DRILL  
(see rules on reverse side)

CARD MUST BE SIGNED

01

Starting Date: July 2, 1984  
month day year

API Number 15- 207-01,001-0048

OPERATOR: License # 7830  
Name Mecca Petroleum Corp.  
Address 140 E. 19th Av., #500  
City/State/Zip Denver, CO 80203  
Contact Person Pamela R. Woodwell  
Phone 303-830-7071

NE SE (location) Sec 26 Twp 25 S, Rge 14  
 East  
 West  
1980 Ft North from Southeast Corner of Section  
1650 Ft West from Southeast Corner of Section  
(Note: Locate well on Section Plat on reverse side)

CONTRACTOR: License # 6112  
Name Long Drilling Co.  
City/State Hamilton, KS

Nearest lease or unit boundary line 660 feet.  
County Woodson  
Lease Name Sheedy Well# 6  
Domestic well within 330 feet:  yes  no  
Municipal well within one mile:  yes  no

Well Drilled For: Well Class: Type Equipment:  
 Oil  Swd  Infield  Mud Rotary  
 Gas  Inj  Pool Ext.  Air Rotary  
 OWWO  Expl  Wildcat  Cable

Depth to Bottom of fresh water 150 feet  
Lowest usable water formation None  
Depth to Bottom of usable water 250 feet  
Surface pipe by Alternate: 1  2   
Surface pipe ~~to be~~ set 40 feet  
Conductor pipe if any required None feet  
Ground surface elevation 1015 feet MSL  
This Authorization Expires 11/2/85  
Approved By 7/2/84 R

If OWWO: old well info as follows:  
Operator Unknown  
Well Name (Sheedy)  
Comp Date Unknown Old Total Depth 696  
Projected Total Depth 700 feet  
Projected Formation at TD Kansas City  
Expected Producing Formations Kansas City

I certify that we will comply with K.S.A. 55-101, et seq., plus eventually plugging hole to K.C.C. specifications.

Date June 29, 1984 Signature of Operator or Agent Pamela R. Woodwell Title Geologist

MHC/KOHE 7-2-84


Must be filed with the K.C.C. five (5) days prior to commencing well  
This card void if drilling not started within six (6) months of date received by K.C.C.

RECEIVED  
STATE CORPORATION COMMISSION

Important procedures to follow

72-84  
JUL 02 1984

**A Regular Section of Land  
1 Mile = 5,280 Ft.**

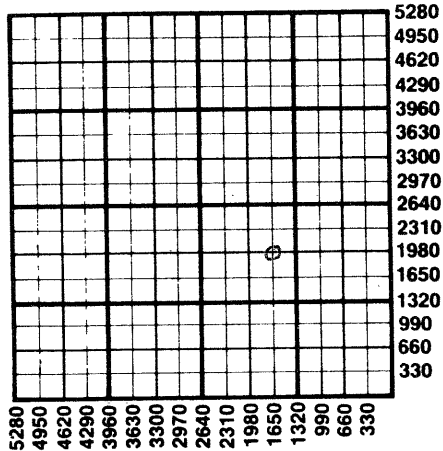

1. Notify District office before setting surface casing.
2. Set surface casing by circulating cement to the top. Wichita, Kansas
3. File completion forms ACO-1 with K.C.C. within 90 days of well completion, following instructions on ACO-1, side 1, and including copies of wireline logs.
4. Notify District office 48 hours prior to old well workover or re-entry.
5. Prior to plugging, prepare a plugging plan, then obtain agreement from the appropriate district office for an approved plugging plan.
6. Submit plugging report (CP-4) to K.C.C. after plugging is completed.
7. Obtain an approved injection docket number before disposing of salt water.
8. Notify K.C.C. within 10 days when injection commences or terminates.
9. If an alternate 2 completion, cement in the production pipe from below any usable water to surface within 120 days of spud date.

State Corporation Commission of Kansas  
Conservation Division  
200 Colorado Derby Building  
Wichita, Kansas 67202  
(316) 263-3238