

CARD MUST BE TYPED

State of Kansas
NOTICE OF INTENTION TO DRILL
(see rules on reverse side)

CARD MUST BE SIGNED

Starting Date: 5 6 85
month day year

API Number 15- 121-01,011-00-01
NW¼
 E SW¼ Sec 10 Twp 19 S, Rge 24 East
 (location)
1920 Ft North from Southeast Corner of Section
4080 Ft West from Southeast Corner of Section
(Note: Locate well on Section Plat on reverse side)


OPERATOR: License # 7573
Name BRUN-JACK Drilling Co.
Address Box 115
City/State/Zip Mound city KS 66056
Contact Person Dale Jackson
Phone 913-795-2081

Nearest lease or unit boundary line 950' feet.
County Miami

CONTRACTOR: License # 6157
Name J&J Oil Co.
City/State Mound City KS

Lease Name Middaugh Well# OW-ID2¼
Domestic well within 330 feet: yes no
Municipal well within one mile: yes no

Well Drilled For: Well Class: Type Equipment:
 Oil Swd Infield Mud Rotary
 Gas Inj Pool Ext. Air Rotary
 OWWO Expl Wildcat Cable

Depth to Bottom of fresh water 150 feet
Lowest usable water formation Pleasanton Gr.
Depth to Bottom of usable water 200 feet
Surface pipe by Alternate: 20 2
Surface pipe to be set feet
Conductor pipe if any required none feet
Ground surface elevation feet MSL
This Authorization Expires 11-6-85
Approved By 5-6-85 

If OWWO: old well info as follows:
Operator N/A Unknown
Well Name N/A
Comp Date N/A Old Total Depth approx. 140 feet
Projected Total Depth 140 feet
Projected Formation at TD Peru
Expected Producing Formations Peru

I certify that we will comply with K.S.A. 55-101, et seq., plus eventually plugging hole to K.C.C. specifications.


Date 5-1-85 Signature of Operator or Agent Dale Jackson Title Operator

MHC/KDHE 5-6-85

**Must be filed with the K.C.C. five (5) days prior to commencing well
This card void if drilling not started within six (6) months of date received by K.C.C.**

Important procedures to follow :

**A Regular Section of Land
1 Mile = 5,280 Ft.**

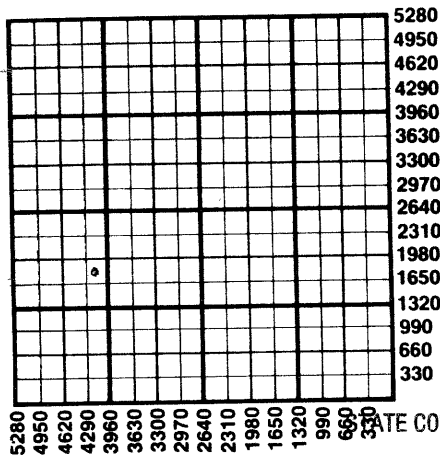

1. Notify District office before setting surface casing.
2. Set surface casing by circulating cement to the top.
3. File completion forms ACO-1 with K.C.C. within 90 days of well completion, following instructions on ACO-1, side 1, and including copies of wireline logs.
4. Notify District office 48 hours prior to old well workover or re-entry.
5. Prior to plugging, prepare a plugging plan, then obtain agreement from the appropriate district office for an approved plugging plan.
6. Submit plugging report (CP-4) to K.C.C. after plugging is completed.
7. Obtain an approved injection docket number before disposing of salt water.
8. Notify K.C.C. within 10 days when injection commences or terminates.
9. If an alternate 2 completion, cement in the production pipe from below any usable water to surface within 120 days of spud date.

RECEIVED

STATE CORPORATION COMMISSION

**State Corporation Commission of Kansas
Conservation Division
200 Colorado Derby Building
Wichita, Kansas 67202
(316) 263-3238**

MAY 06 1985

CONSERVATION DIVISION
Wichita, Kansas