

CARD MUST BE TYPED

State of Kansas
NOTICE OF INTENTION TO DRILL
(see rules on reverse side)

CARD MUST BE SIGNED

Starting Date: 4/10/85
month day year

API Number 15-003-22,610-00-00

OPERATOR: License # 6004

NW NE SE East
..... Sec 22 Twp 21 S, Rge 21 West
(location)

Name Caldwell Enterprises

Address Box 42

City/State/Zip Garnett, Ks 66032

Contact Person Glen Caldwell

Phone 913-448-3578

.....2420..... Ft North from Southeast Corner of Section

.....1100..... Ft West from Southeast Corner of Section

(Note: Locate well on Section Plat on reverse side)

CONTRACTOR: License # 5820

Name Milton J. Kent

City/State Garnett, KS 66032

Nearest lease or unit boundary line 220 feet.

County Anderson

Lease Name Bailey Well# 19

Domestic well within 330 feet: yes no

Municipal well within one mile: yes no

Well Drilled For: Well Class: Type Equipment:

- Oil Swd Infield Mud Rotary
- Gas Inj Pool Ext. Air Rotary
- OWWO Expl Wildcat Cable

Depth to Bottom of fresh water 30 feet

Lowest usable water formation

Depth to Bottom of usable water 100 feet

Surface pipe by Alternate: 1 2

Surface pipe to be set

Conductor pipe if any required

Ground surface elevation

This Authorization Expires 10-8-85

Approved By REH/KCC 4-8-85

If OWWO: old well info as follows:

Operator

Well Name

Comp Date Old Total Depth

Projected Total Depth 650 feet

Projected Formation at TD

Expected Producing Formations

I certify that we will comply with K.S.A. 55-101, et seq., plus eventually plugging hole to K.C.C. specifications.

Date 4/8/85 Signature of Operator or Agent

Susan Arnold

Title As Agent


mhc/wdhe 4-9-85

RECEIVED
 STATE CORPORATION COMMISSION

Must be filed with the K.C.C. five (5) days prior to commencing well
 This card void if drilling not started within six (6) months of date received by K.C.C.

APR 04 1985
 04-08-85
 CONSERVATION DIVISION
 Wichita, Kansas

A Regular Section of Land
1 Mile = 5,280 Ft.

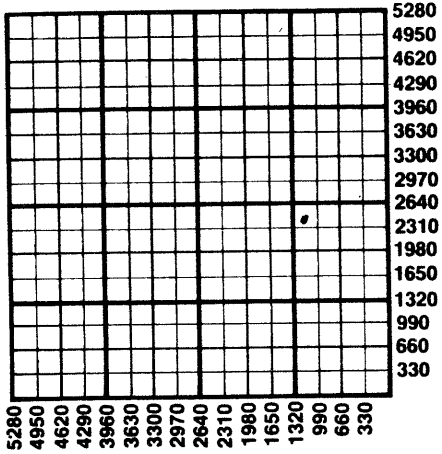

Important procedures to follow :

1. Notify District office before setting surface casing.
2. Set surface casing by circulating cement to the top.
3. File completion forms ACO-1 with K.C.C. within 90 days of well completion, following instructions on ACO-1, side 1, and including copies of wireline logs.
4. Notify District office 48 hours prior to old well workover or re-entry.
5. Prior to plugging, prepare a plugging plan, then obtain agreement from the appropriate district office for an approved plugging plan.
6. Submit plugging report (CP-4) to K.C.C. after plugging is completed.
7. Obtain an approved injection docket number before disposing of salt water.
8. Notify K.C.C. within 10 days when injection commences or terminates.
9. If an alternate 2 completion, cement in the production pipe from below any usable water to surface within 120 days of spud date.

State Corporation Commission of Kansas
Conservation Division
200 Colorado Derby Building
Wichita, Kansas 67202
(316) 263-3238