

★ No Plugging Record  
CARD MUST BE TYPED

State of Kansas  
**NOTICE OF INTENTION TO DRILL**  
(see rules on reverse side)

CARD MUST BE SIGNED

Starting Date: 4-27-85  
month day year

API Number 15- 207-01,004-0000

OPERATOR: License # 6436  
Name Leedy-Beaman Oil Prod.  
Address 214 N. Highland  
City/State/Zip Chanute, Ks. 66720  
Contact Person Robert Leedy  
Phone 316-431-0426

NE SE SE (location) Sec 5 Twp 24 S, Rge 17  East  West

CONTRACTOR: License # 6436  
Name Company tools  
City/State .....

835 Ft North from Southeast Corner of Section  
165 Ft West from Southeast Corner of Section  
(Note: Locate well on Section Plat on reverse side)

Well Drilled For: Well Class: Type Equipment:  
 Oil  Swd  Infield  Mud Rotary  
 Gas  Inj  Pool Ext.  Air Rotary  
 OWWO  Expl  Wildcat  Cable

Nearest lease or unit boundary line 165 feet.  
County Woodson  
Lease Name D. Ellis Well# 7  
Domestic well within 330 feet:  yes  no  
Municipal well within one mile:  yes  no

If OWWO: old well info as follows:  
Operator Leedy-Beaman Oil Prod.  
Well Name D. Ellis  
Comp Date 1938? Old Total Depth 1200  
Projected Total Depth 1200 feet  
Projected Formation at TD Miss. Lime  
Expected Producing Formations Miss. Lime

Depth to Bottom of fresh water 25 feet  
Lowest usable water formation 25  
Depth to Bottom of usable water ..... feet  
Surface pipe by Alternate: 1  2  
Surface pipe ~~to be~~ set 40 feet  
Conductor pipe if any required ..... feet  
Ground surface elevation ..... feet MSL  
This Authorization Expires 7-28-85  
Approved By [Signature]

I certify that we will comply with K.S.A. 55-101, et seq., plus eventually plugging hole to K.C.C. specifications.  
4" casing set to TD. now.

Date 3-27-85  
Signature of Operator or Agent


Robert B. Leedy Title Operator  
Form C-1 4/84  
MHC/140HE 3-28-85

Must be filed with the K.C.C. five (5) days prior to commencing well  
This card void if drilling not started within six (6) months of date received by K.C.C.

3-28-85  
RECEIVED  
STATE CORPORATION COMMISSION

Important procedures to follow: MAR 28 1985

A Regular Section of Land  
1 Mile = 5,280 Ft.

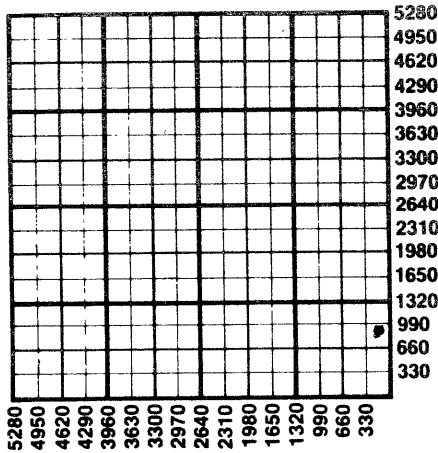

1. Notify District office before setting surface casing. CONSERVATION DIVISION  
Wichita, Kansas
2. Set surface casing by circulating cement to the top.
3. File completion forms ACO-1 with K.C.C. within 90 days of well completion, following instructions on ACO-1, side 1, and including copies of wireline logs.
4. Notify District office 48 hours prior to old well workover or re-entry.
5. Prior to plugging, prepare a plugging plan, then obtain agreement from the appropriate district office for an approved plugging plan.
6. Submit plugging report (CP-4) to K.C.C. after plugging is completed.
7. Obtain an approved injection docket number before disposing of salt water.
8. Notify K.C.C. within 10 days when injection commences or terminates.
9. If an alternate 2 completion, cement in the production pipe from below any usable water to surface within 120 days of spud date.

State Corporation Commission of Kansas  
Conservation Division  
200 Colorado Derby Building  
Wichita, Kansas 67202  
(316) 263-3238