

CARD MUST BE TYPED

State of Kansas

CARD MUST BE SIGNED

NOTICE OF INTENTION TO DRILL

(see rules on reverse side)

Expected Spud Date..... 08/08/88.....
month day year

API Number 15- 003-22,918-00-00 ¹⁰
NW NE NE Sec. 18. Twp. 21. S, Rg. 21... XX East
5030..... Ft. from South Line of Section
1125..... Ft. from East Line of Section

OPERATOR: License # 5820.....
Name KENT DRILLING.....
Address 333 WEST 8th.....
City/State/Zip GARNETT, KANSAS 66032.....
Contact Person..... JERRY KENT.....
Phone..... (913) 448-3762.....

(Note: Locate well on Section Plat on reverse side)

Nearest lease or unit boundary line 1070... feet
County..... ANDERSON.....
Lease Name..... KENT..... Well #..... 1.....

CONTRACTOR: License #
Name CO. TOOLS.....
City/State

Ground surface elevation feet MSL
Domestic well within 330 feet: ___yes XXno
Municipal well within one mile: ___yes XXno
Depth to bottom of fresh water.....
Depth to bottom of usable water 125.100'.....

Well Drilled For: Well Class: Type Equipment:
XX Oil ___ Storage XXInfield XX Mud Rotary
___ Gas ___ Inj ___ Pool Ext. ___ Air Rotary
___ OWWO ___ Expl ___ Wildcat ___ Cable

Surface pipe by Alternate: 1 XX
Surface pipe planned to be set 20.....
Conductor pipe required
Projected Total Depth 750..... feet
Formation SQUIRREL.....

If OWWO: old well info as follows:
Operator
Well Name
Comp Date Old Total Depth.....

I certify that well will comply with K.S.A. 55-101, et seq., plus eventually plugging hole to KCC specifications.
Date 08/04/88... Signature of Operator or Agent [Signature] Title AS. AGENT.....

For KCC Use:
Conductor Pipe Required feet; Minimum Surface Pipe Required 20' feet per Alt. X (2)
This Authorization Expires 2-4-89..... Approved By LKM/8-4-88.....


EFFECTIVE DATE: 8-9-88

Must be filed with the K.C.C. five (5) days prior to commencing well
 This card void if drilling not started within six (6) months of date received by K.C.C.

Important procedures to follow:

1. Notify District office before setting surface casing.
 2. Set surface casing by circulating cement to the top.
 3. File completion forms ACO-1 with K.C.C. within 120 days of well spud date, following instructions on ACO-1, side 1, and including copies of wireline logs.
 4. Notify District office 48 hours prior to old well workover or re-entry.
 5. Prior to filing Intent, prepare a proposed plugging plan in case well is D & A, then obtain approval of plan when calling district office prior to setting surface pipe.
 6. Submit plugging report (CP-4) to K.C.C. after plugging is completed.
 7. Obtain an approved injection docket number before disposing of salt water.
 8. Notify K.C.C. within 10 days when injection commences or terminates.
9. In alternate 2 completion, cement in the production pipe from below any usable water to surface within 120 days of spud date.

**A Regular Section of Land
 1 Mile = 5,280 Ft.**

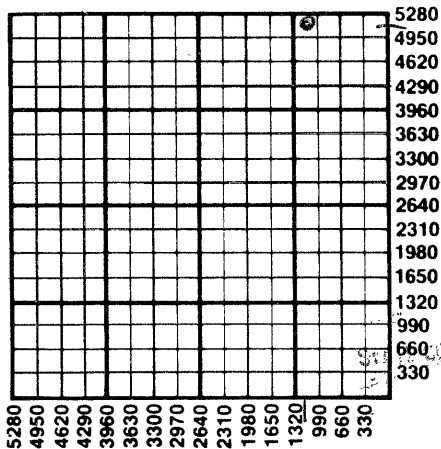

RECEIVED
 AUG 4 1988
 08-04-88
 CONSERVATION DIVISION
 WICHITA, KANSAS

State Corporation Commission of Kansas
 Conservation Division
 200 Colorado Derby Building
 Wichita, Kansas 67202-1212
 (316) 263-3238